

Seventh Bend Seventh Bend - Stage 13

Drawing Index

POINT

C35SSPL

C36SSPL

C45SSPL

C46SSPL

20.08.20

2250E-13-01 Cover Plan 2250E-13-02 Layout Plan

2250E 13-03 Earthworks & Retaining Wall Setout Plan

2250E-13-04 Intersection Detail Plan - 1 2250E-13-05 Intersection Detail Plan - 2

2250E-13-06 Longitudinal Sections - 1

2250E-13-07 Longitudinal Sections - 2 2250E-13-08 Cross Sections: Shelterbelt Avenue Ch 687.10 - Ch 826.12

2250E-13-09 Cross Sections: Shelterbelt Avenue Ch 838.62 - Ch 941.87

2250E-13-10 Cross Sections: Shelterbelt Avenue Ch 950.37 - Ch 985.12 and Samuel Road Ch 225.89 - Ch 249.39 2250E-13-11 Cross Sections: Samuel Road Ch 269.57 - Ch 415.93

2250E-13-12 Cross Sections: Grazing Road

2250E-13-13 Cross Sections: Landmark Road and Shallow Road

2250E-13-14 Drainage Longitudinal Sections - 1

2250E-13-15 Drainage Longitudinal Sections - 2 2250E-13-16 Drainage Longitudinal Sections - 3


2250E-13-17 Drainage Longitudinal Sections - 4

2250E-13-18 Pit Schedule


2250E-13-19 Signage & Linemarking Plan


2250E-13-20 Pavement Details 2250E-13-21 General Notes and Details

2250E-13-85 Safety In Design

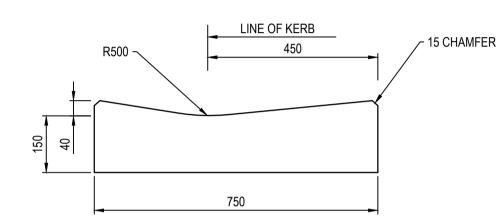

750 INVERT CHANNEL DETAIL TO INTERSECT WITH 600 WIDTH BARRIER KERB AND CHANNEL DETAIL SCALE 1:10 **EDCM**

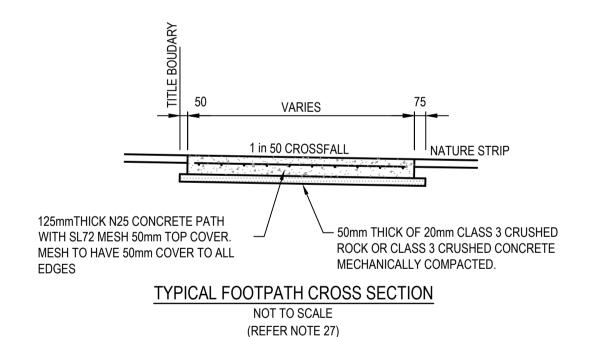


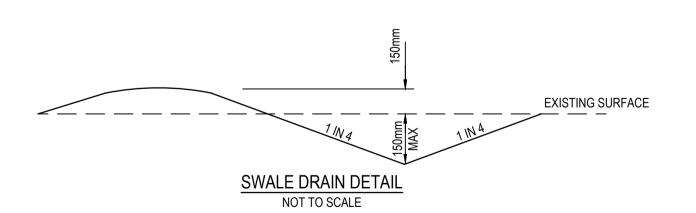



N.Green

AUTHORISED

REFERENCE No.

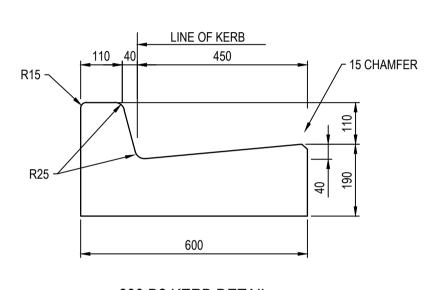

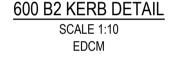

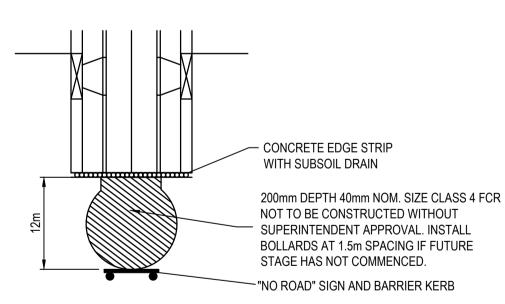

TYPICAL TEMPORARY TURN AREA DETAIL NOT TO SCALE

GENERAL NOTES (MELTON CITY COUNCIL)

1. ALL WORKS TO BE CARRIED OUT IN ACCORDANCE WITH A.S. 4000-1992 GENERAL CONDITIONS OF CONTRACT AND CURRENT MELTON CITY COUNCIL SPECIFICATIONS AND EDCM ADDENDUM STANDARD DRAWINGS AND TO THE SATISFACTION OF THE SUPERVISING

THE CONTRACTOR IS RESPONSIBLE FOR SAFETY OF WORK ON SITE IN ACCORDANCE WITH APPROPRIATE LEGISLATION. THEY SHALL ERECT AND MAINTAIN ALL SHORING, PLANKING AND STRUTTING, DEWATERING DEVICES, BARRICADES, SIGNS, LIGHTS, ETC. NECESSARY TO KEEP WORKS IN A SAFE AND STABLE CONDITION, AND TO PROTECT THE PUBLIC FROM HAZARDS ASSOCIATED WITH THE WORKS.

3. THE CONTRACTOR SHALL

COMPLY WITH THE SAFETY REQUIREMENTS OF THE MINES ACT, GENERAL REGULATIONS AND STATUTORY RULES, AND THE MINES (TRENCHES) REGULATIONS 1982.

NOTIFY THE OCCUPATIONAL HEALTH AND SAFETY AUTHORITY OF HIS INTENTION TO COMMENCE TRENCHING OPERATIONS

WHERE TRENCHES ARE 1.5 METRES OR DEEPER. ENSURE THAT THE MINE MANAGER OR HIS DEPUTY AS REQUIRED BY THE REGULATIONS IS IN ATTENDANCE WHEN TRENCHING

THE CONTRACTOR IS TO NOTIFY COUNCIL AND ALL SERVICE AUTHORITIES SEVEN (7) DAYS PRIOR TO COMMENCEMENT OF

TREES MARKED ON THE APPROVED PLANS FOR REMOVAL MUST BE REMOVED FROM THE SITE PRIOR TO THE COMMENCEMENT OF WORKS. NO EXCAVATION SHALL BE CARRIED OUT WITHIN 5.0m OF ANY EXISTING TREE UNTIL APPROVAL HAS BEEN GIVEN BY ALL ROAD CHAINAGES ARE MEASURED ALONG THE ROAD CENTRELINE EXCEPT KERB RETURNS AND COURTHEADS. WHERE LIP OF

KERB CHAINAGES ARE SPECIFIED. ALL DIMENSIONS AND RADII ARE GIVEN TO THE LIP OF KERB. DO NOT SCALE OFF THESE DRAWINGS WRITTEN DIMENSIONS ONLY SHALL BE USED. 8. THE CONTRACTOR WHEN ENGAGED IN BLASTING OPERATION, SHALL NOT BLAST WITHIN 4.5m OF AN EXISTING LINE OF WATER, GAS

OR SEWER PIPES OR WITHIN 15m OF ANY COMPLETED PART OF THE WORKS WITHOUT THE CONSENT OF THE ENGINEER AND MUST.

THE CONTRACTOR IS TO OBTAIN THE NECESSARY ROAD OPENING PERMIT PRIOR TO UNDERTAKING ANY WORKS WITHIN A PREVIOUSLY CONSTRUCTED ROADWAY.

10. ALL LEVELS ARE TO AUSTRALIAN HEIGHT DATUM.

11. THE CONTRACTOR SHALL CO-OPERATE WITH OTHER AUTHORITIES AND SHALL ENSURE THAT ALL SERVICES ARE INSTALLED PRIOR TO THE FINAL PAVEMENT COURSE.

12. ANY EXISTING PAVEMENT OR DRAINAGE WORKS DAMAGED DURING CONSTRUCTION OR THE MAINTENANCE PERIOD TO BE REINSTATED TO THE SATISFACTION OF THE COUNCIL REPRESENTATIVE

TBM'S TO BE MAINTAINED AND PROTECTED BY THE CONTRACTOR FOR THE DURATION OF THE WORKS

CONSTRUCTION SITES. THE CONTRACTOR IS TO CONSTRUCT SEDIMENT TRAPS AT THE ENDS OF ALL TEMPORARY CHANNELS AND

RELATIVE COMPACTION COMPARED TO A STANDARD COMPACTION TEST AS SPECIFIED BY VIC ROADS OF

- 95% FOR ALL FILL GREATER THAN 450mm FROM THE SURFACE. ADDITIONAL AND OVEREXCAVATION SHALL BE BACKFILLED IN ACCORDANCE WITH THE PROVISIONS OF THE SPECIFICATION

THE NATURE STRIPS AND CUT OR FILLED AREAS ARE TO BE TOPSOILED WITH 100mm OF APPROVED MATERIAL

- 100% FOR ALL FILL MATERIAL AND MATERIAL UNDER FILL THAT IS LESS THAN 450mm FROM THE SURFACE.

STANDARD COMPACTION TEST IN AREAS OF CUT TO A DEPTH OF 150mm AND IN AREAS OF FILL TO A DEPTH OF 450mm

- FOR DEPTH 0-100mm BELOW TOP OF BASE, RELATIVE COMPACTION OF 100%

- FOR DEPTH 100-300mm BELOW TOP OF BASE, RELATIVE COMPACTION OF 98%.

- FOR DEPTH OVER 300mm BELOW TOP OF BASE, RELATIVE COMPACTION OF 97%

TO PLACEMENT OF CONCRETE WORKS. GAS AND WATER CONDUITS TO BE 50mm DIA. HEAVY DUTY PVC LAID AT A MINIMUM DEPTH OF 600mm BELOW ROAD FINISHED SURFACE LEVELS. FOR DUAL WATER SUPPLY CONDUIT SHALL BE 100mm DIA.

23. ALL SERVICING TRENCHES UNDER ROADS, FOOTPATHS, DRIVEWAYS, PARKING BAYS ETC, ARE TO BE BACKFILLED WITH CLASS 2 FCR. 24. ALL HOUSE DRAIN CONNECTIONS ARE TO BE LOCATED NO CLOSER THAN 6.00m FROM THE SIDE BOUNDARY OR FROM ANY EASEMENT

25. ALL PROPERTY INLETS TO BE LOCATED 1.0m FROM THE LOW SIDE BOUNDARY UNLESS OTHERWISE SHOWN. THEY ARE TO BE LAID AT

A MINIMUM DEPTH OF 400mm AS SPECIFIED IN THE STANDARD DRAWINGS. 26. DRAINAGE PITS SHALL BE CAST MONOLITHICALLY. CEMENT RENDER SHALL ONLY BE USED TO REPAIR DEFECTS.

27. ALL RESIDENTIAL FOOTPATHS TO BE MINIMUM 1.50m WIDE UNLESS OTHERWISE INDICATED. FOOTPATH TO BE 125mm THICK N25

CONCRETE REINFORCED WITH SL72 MESH ON 50mm COMPACTED DEPTH 20mm CLASS 3 FCR BASE, AS PER EDCM 401. 28. ALL RESIDENTIAL DRIVEWAYS TO BE CONSTRUCTED IN ACCORDANCE WITH EDCM 501 TO 503. SINGLE DRIVEWAYS TO BE OFFSET

29. ALL ALLOTMENTS AND RESERVES SHALL BE SMOOTHED, GRADED AND SHAPED TO AN EVEN SURFACE. 30. APPROVAL FOR THE REMOVAL AND DISPOSAL OF ANY EXCAVATED MATERIAL OR TOPSOIL IS REQUIRED FROM COUNCIL.

31. THE CONTRACTOR TO ERECT STREET NAME SIGNS & POLE AS DIRECTED BY THE SUPERINTENDENT. 32. ALL LINEMARKING, SIGNING & TRAFFIC CONTROL DEVICES FOR THIS PROJECT TO BE IN ACCORDANCE WITH AUSTRALIAN STANDARD

AS1742. ALL LINEMARKING TO BE LONG LIFE THERMOPLASTIC PAINT. 33. CONFIRMATION OF THE ASPHALT WEARING COURSE IS TO BE DEFFERED UNTIL INSTRUCTED BY THE SUPERINTENDENT

34. ALL EXOTIC (NON-NATIVE) TREES AND SHRUBS, INCLUDING DEAD TREES, NOT SHOWN ON THE DRAWINGS BUT LOCATED WITHIN THE

WORKS AREA TO BE REMOVED AND DISPOSED OFFSITE 35. ALL EXCAVATED OR FILLED AREAS OUTSIDE THE ROAD RESERVE SHALL BE SURFACED WITH A 100mm LAYER TOPSOIL AS SPECIFIED.

ALL FILLING ON ALLOTMENTS TO BE COMPACTED TO 95% STANDARD COMPACTION IN 150mm LAYERS AND AS PER THE SPECIFICATION. WHERE THERE IS FILL IN EXCESS OF 300mm IN DEPTH, THE CONTRACTOR IS TO CARRY OUT SOIL TESTS TO THE REQUIREMENTS OF SECTION 8 AS SPECIFIED IN AS3798-1996 TO SHOW THAT THE REQUIRED COMPACTION HAS BEEN ACHIEVED

36. INSTALL BLUE RAISED REFLECTIVE PAVEMENT MARKER (BRRPM) ON ROAD CENTRELINE AND "GROUND BALL" MARKER POST TO INDICATE LOCATION OF FIRE PLUG.

37. UPON COMPLETION OF CONSTRUCTION, THE WHOLE SITE SHALL BE CLEANED UP AND GRADED OVER. ALL RUBBISH IS TO BE

REMOVED AND THE SITE IS TO BE LEFT IN A CLEAN AND TIDY CONDITION TO THE SATISFACTION OF THE SUPERINTENDENT. 38. ALL DRAINAGE PIT COVERS AND GRATES IN ACCORDANCE WITH EDCM 601 TO 608

39. PIPE TRENCHES WITHIN THE ROAD RESERVE MUST BE BACKFILLED WITH 20mm CL3 CR TO BE COMPACTED TO A DRY DENSITY NOT LESS THAN 97% OF THE MAXIMUM FOUND IN THE STANDARD COMPACTION:

BENEATH THE ROAD PAVEMENT OR DRIVEWAY CROSSOVER TO THE UNDERSIDE OF THE PAVEMENT OR CROSSOVER ADJACENT TO KERBING OR CONCRETE WORKS TO A LEVEL THAT IS NOT AFFECTED BY A 45° ANGLE OF REPOSE FROM THE NEAR

AUSNET SERVICES (GAS) - STANDARD NOTES

0.75m FROM SIDE BOUNDARY OR EASEMENT.

GAS MAINS. FITTINGS AND MARKER TAPE ARE TO BE SUPPLIED BY AUSNET SERVICES.

2. CONTRACTOR RESPONSIBLE FOR EXCAVATION OF TRENCH, SUPPLY AND PLACEMENT OF REQUIRED BEDDING AND BACKFILLING IN ACCORDANCE WITH AUSNET SERVICES SPECIFICATIONS 1601.

3. TRENCH SHOULD BE WIDE ENOUGH TO ACCOMMODATE AUSNET SERVICES INFRASTRUCTURE IN ACCORDANCE WITH AUSNET

4. CONTRACTOR TO NOTIFY AUSNET SERVICES A MINIMUM OF TWENTY (20) WORKING DAYS PRIOR OF COMMENCEMENT OF

CONSTRUCTION TO SCHEDULE WORKS.

SAFETY MEASURES REQUIRE Please note there are risks attached to the construction of this project, and any ongoing maintenance of structures. Consider the safety of all. For potential risks, consequences and controls refer to Safety In Design Risk Register SID P4.E6. 2250E-13-85

SEVEN[™]

ASSESS THE RISK - STAY SAFE

WARNING BEWARE OF UNDERGROUND SERVICES he locations of underground services are approximate only and

their exact position should be proven on site. No guarantee is given that all existing services are shown. ocate all underground services before commencement of works **DIAL 1100 BEFORE YOU DIG**

Seventh Bend - Stage 13 Road and Drainage

Cover Plan

(C) ABN 47 065 475 149 BEND Tower 4, Level 20, 727 Collins Street Docklands, VIC 3008 Ph 03 9514 1500 SCALE AS SHOWN AT A1

Member of the Surbana Jurong Group

SMEC

PROJECT / DRAWING No. MELWAYS REF 2250E-13-01

01 of 22 B

DWG PATH: V:_Vault\Projects_Urban\2250E-Exford Road, Melton\2250E-13\Dwgs\2250E-13-01.dwg PRINTED BY: AM13398 on 24/08/2020 at 07:02:17 PM

SUBJECT TO APPROVAL

TBM SETOUT TABLE

286,274.86

286,396.6

286,349.44

286,271.83

AMENDMENT / REVISION DESCRIPTION

ISSUED TO COUNCIL FOR APPROVAL

CHANGES MADE TO PAGE NAMES

NORTHING

5,822,408.41

5,822,378.08

5,822,239.61

5,822,132.01

ELEVATION

108.49

108.25

107.79

107.22

AM


LV


All setting out should be carried out in accordance with MPA/Council's


standard drawings or as nominated on hard copy plans provided by


SMEC. Any digital information supplied by this office is for information


only. Any discrepancies should be discussed with the superintendent.

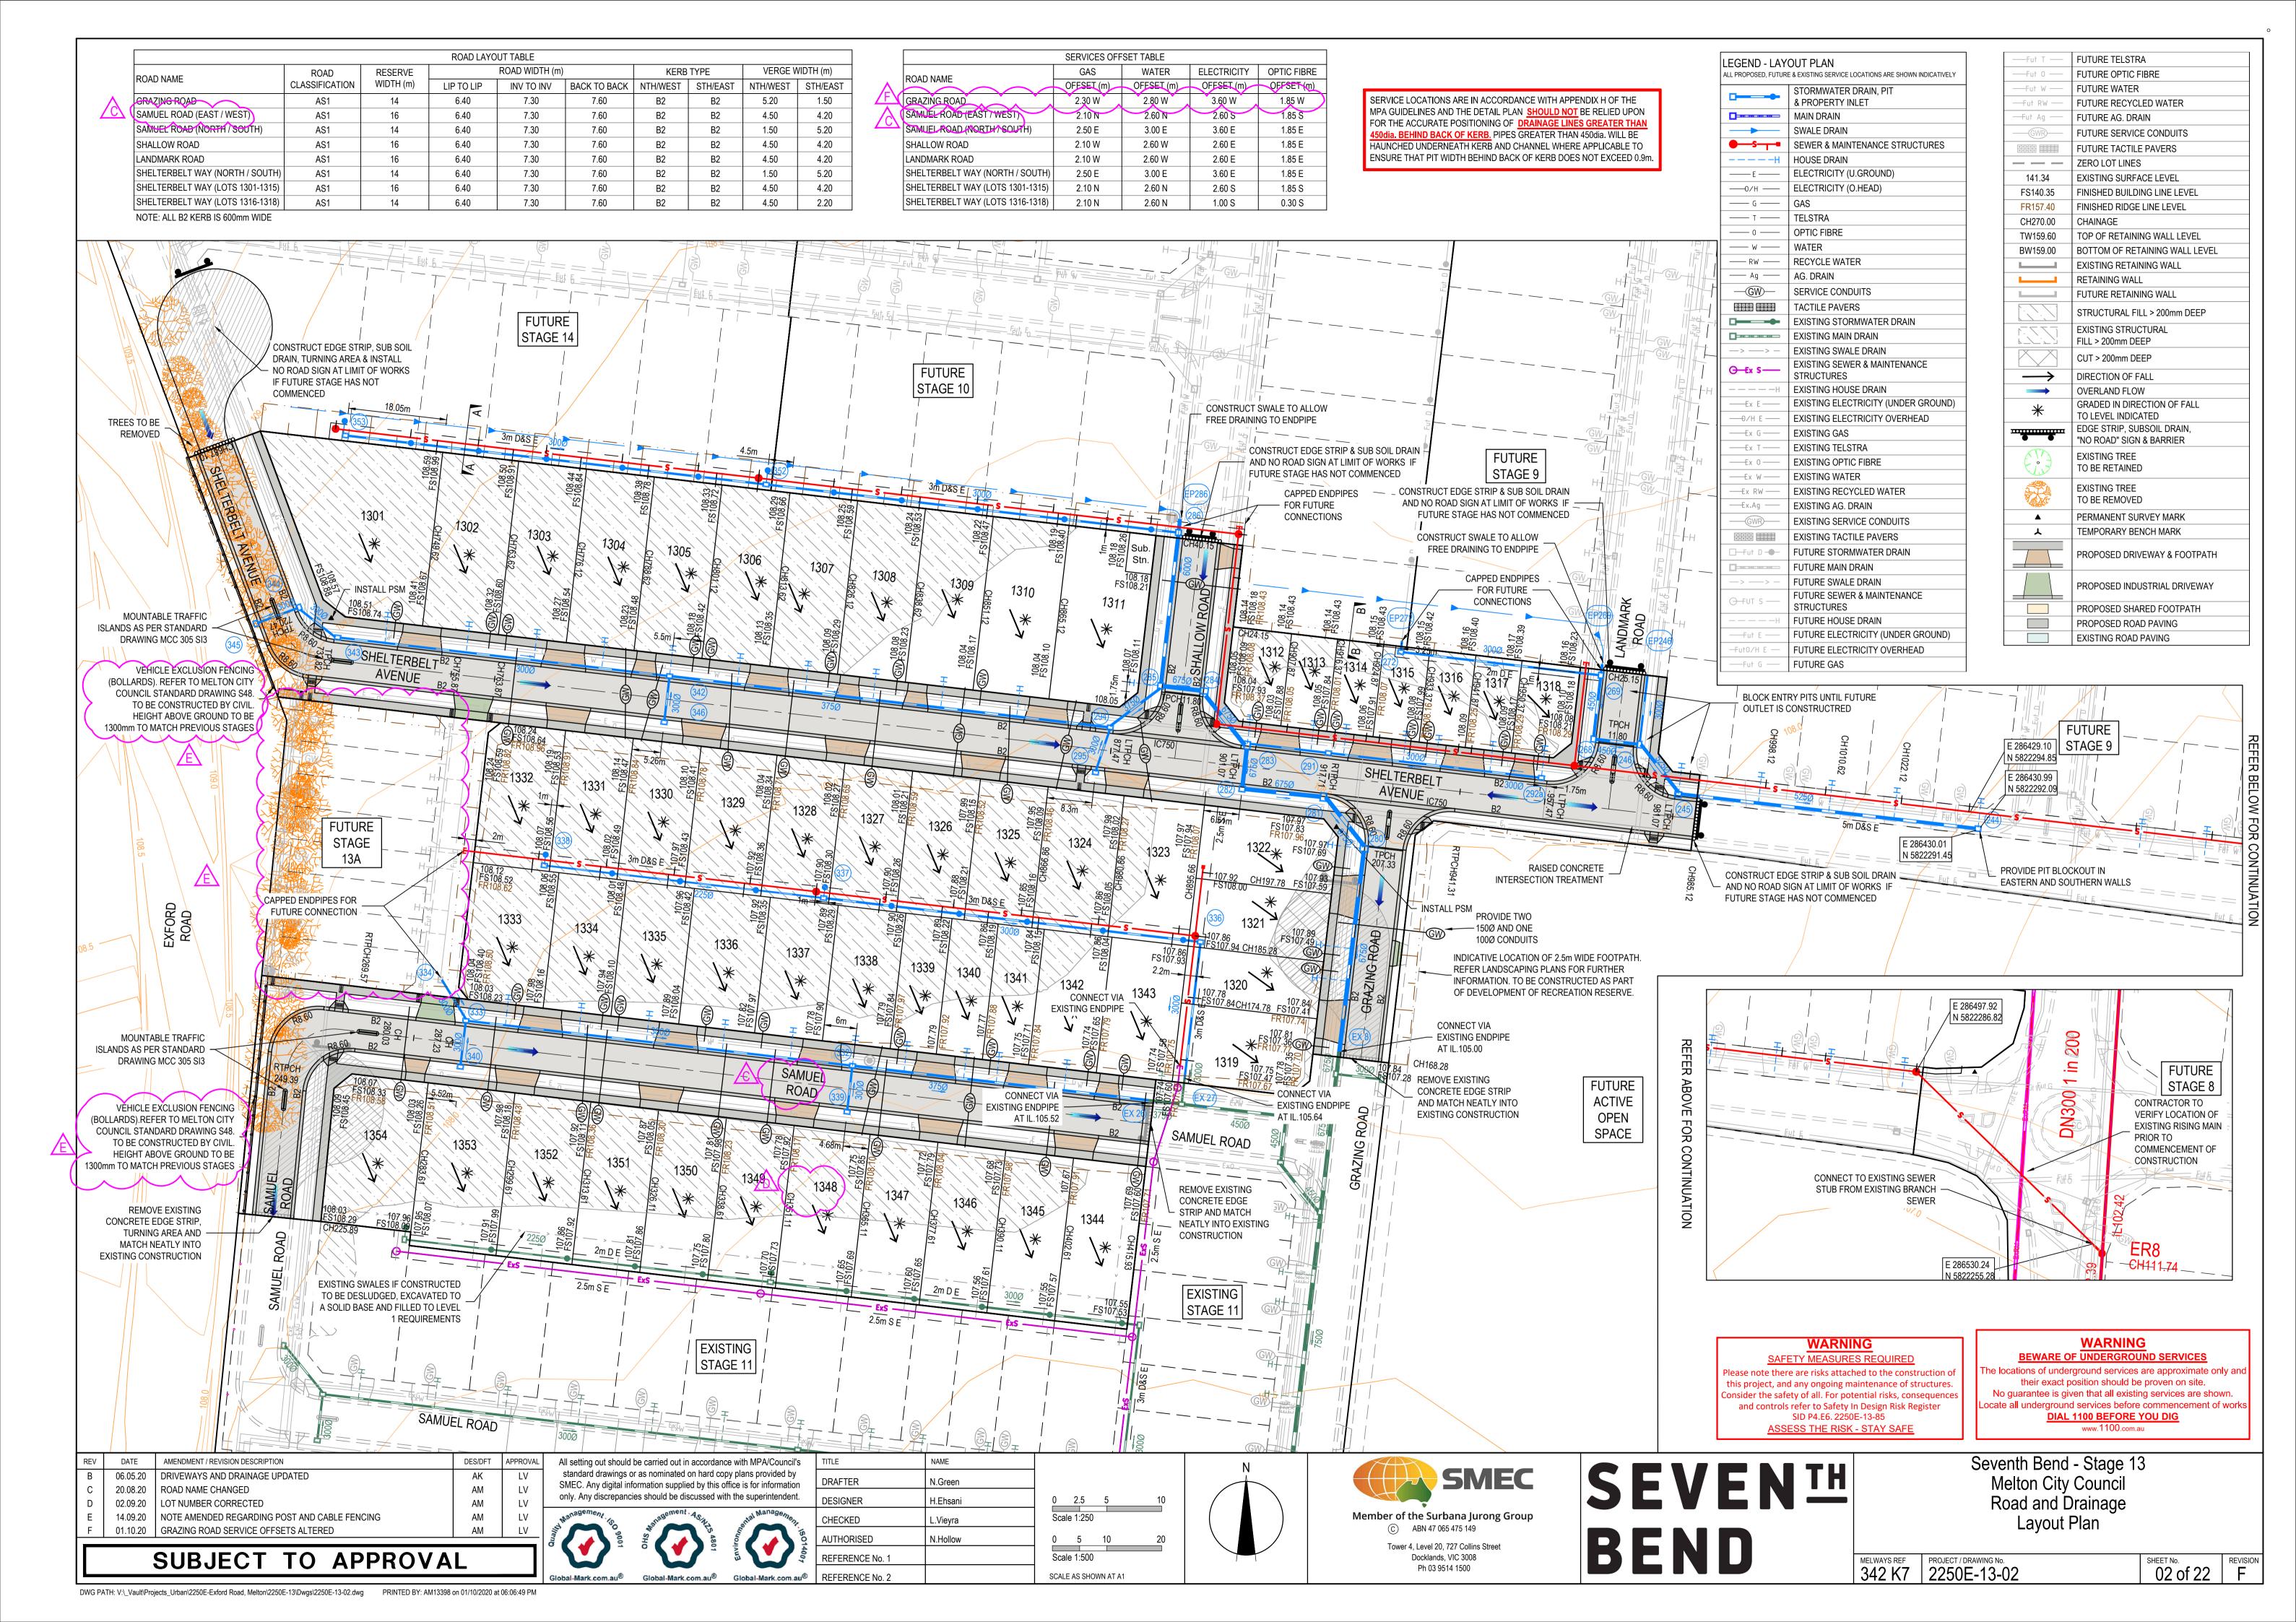

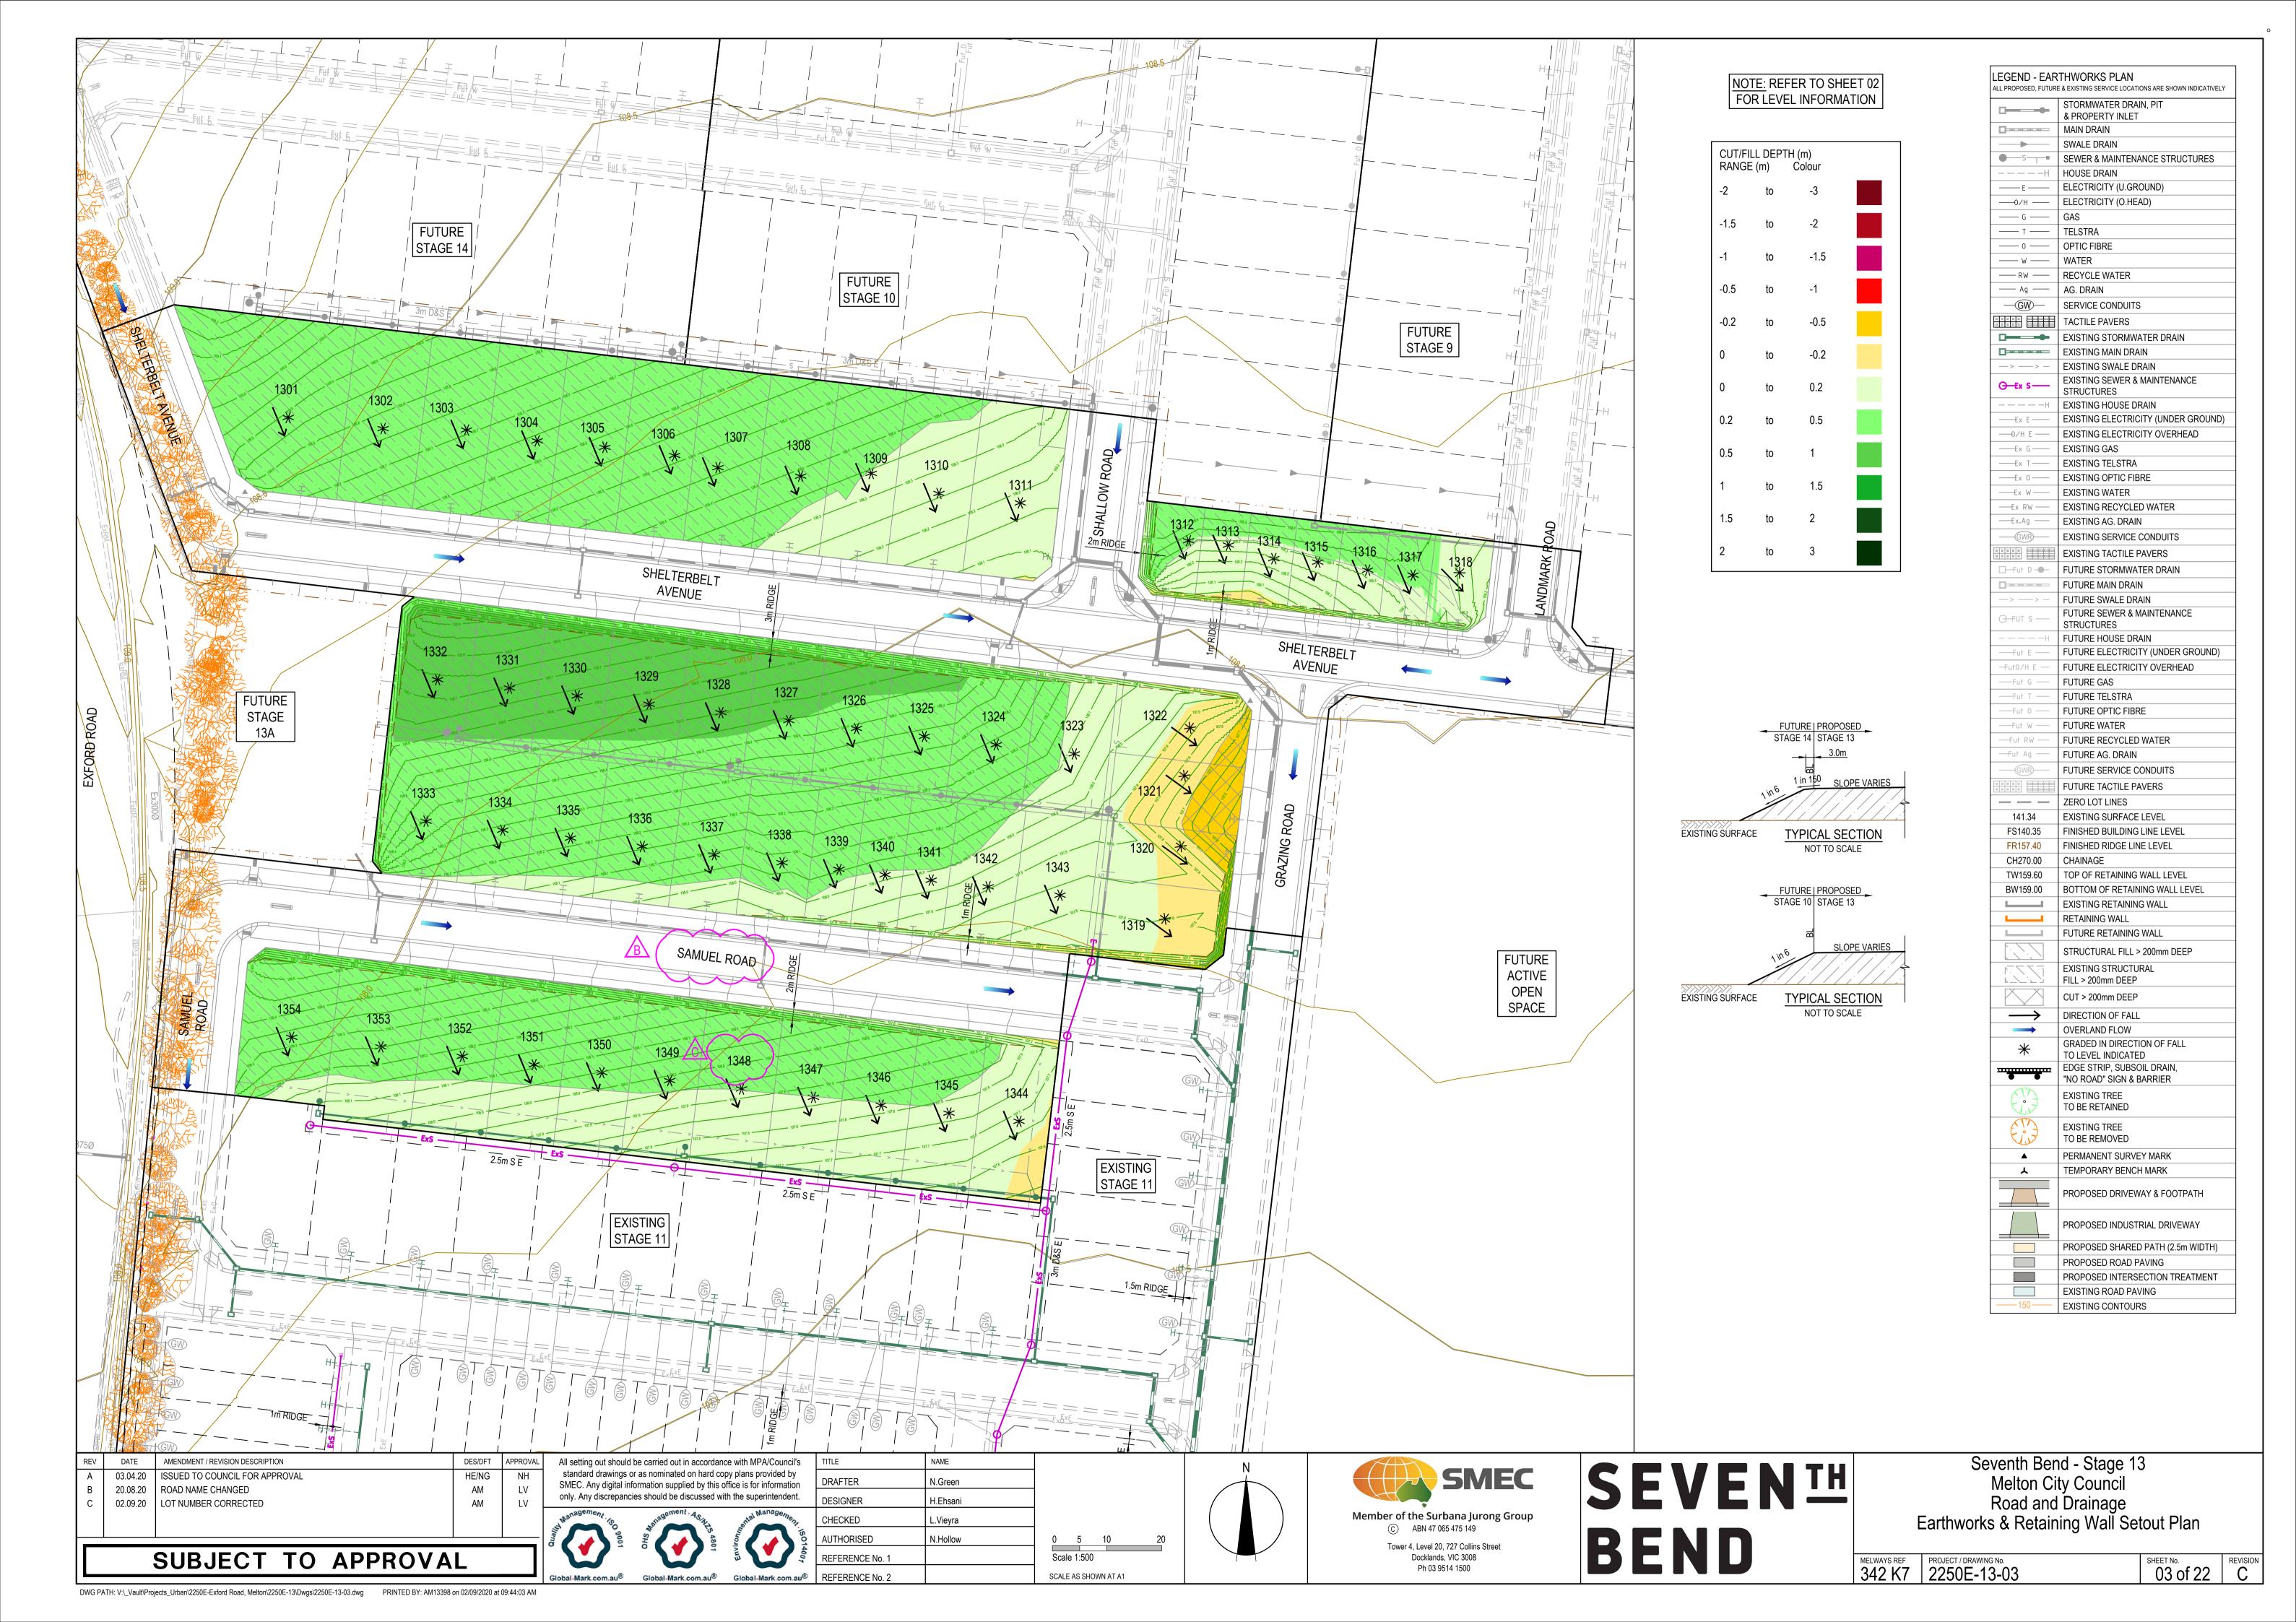


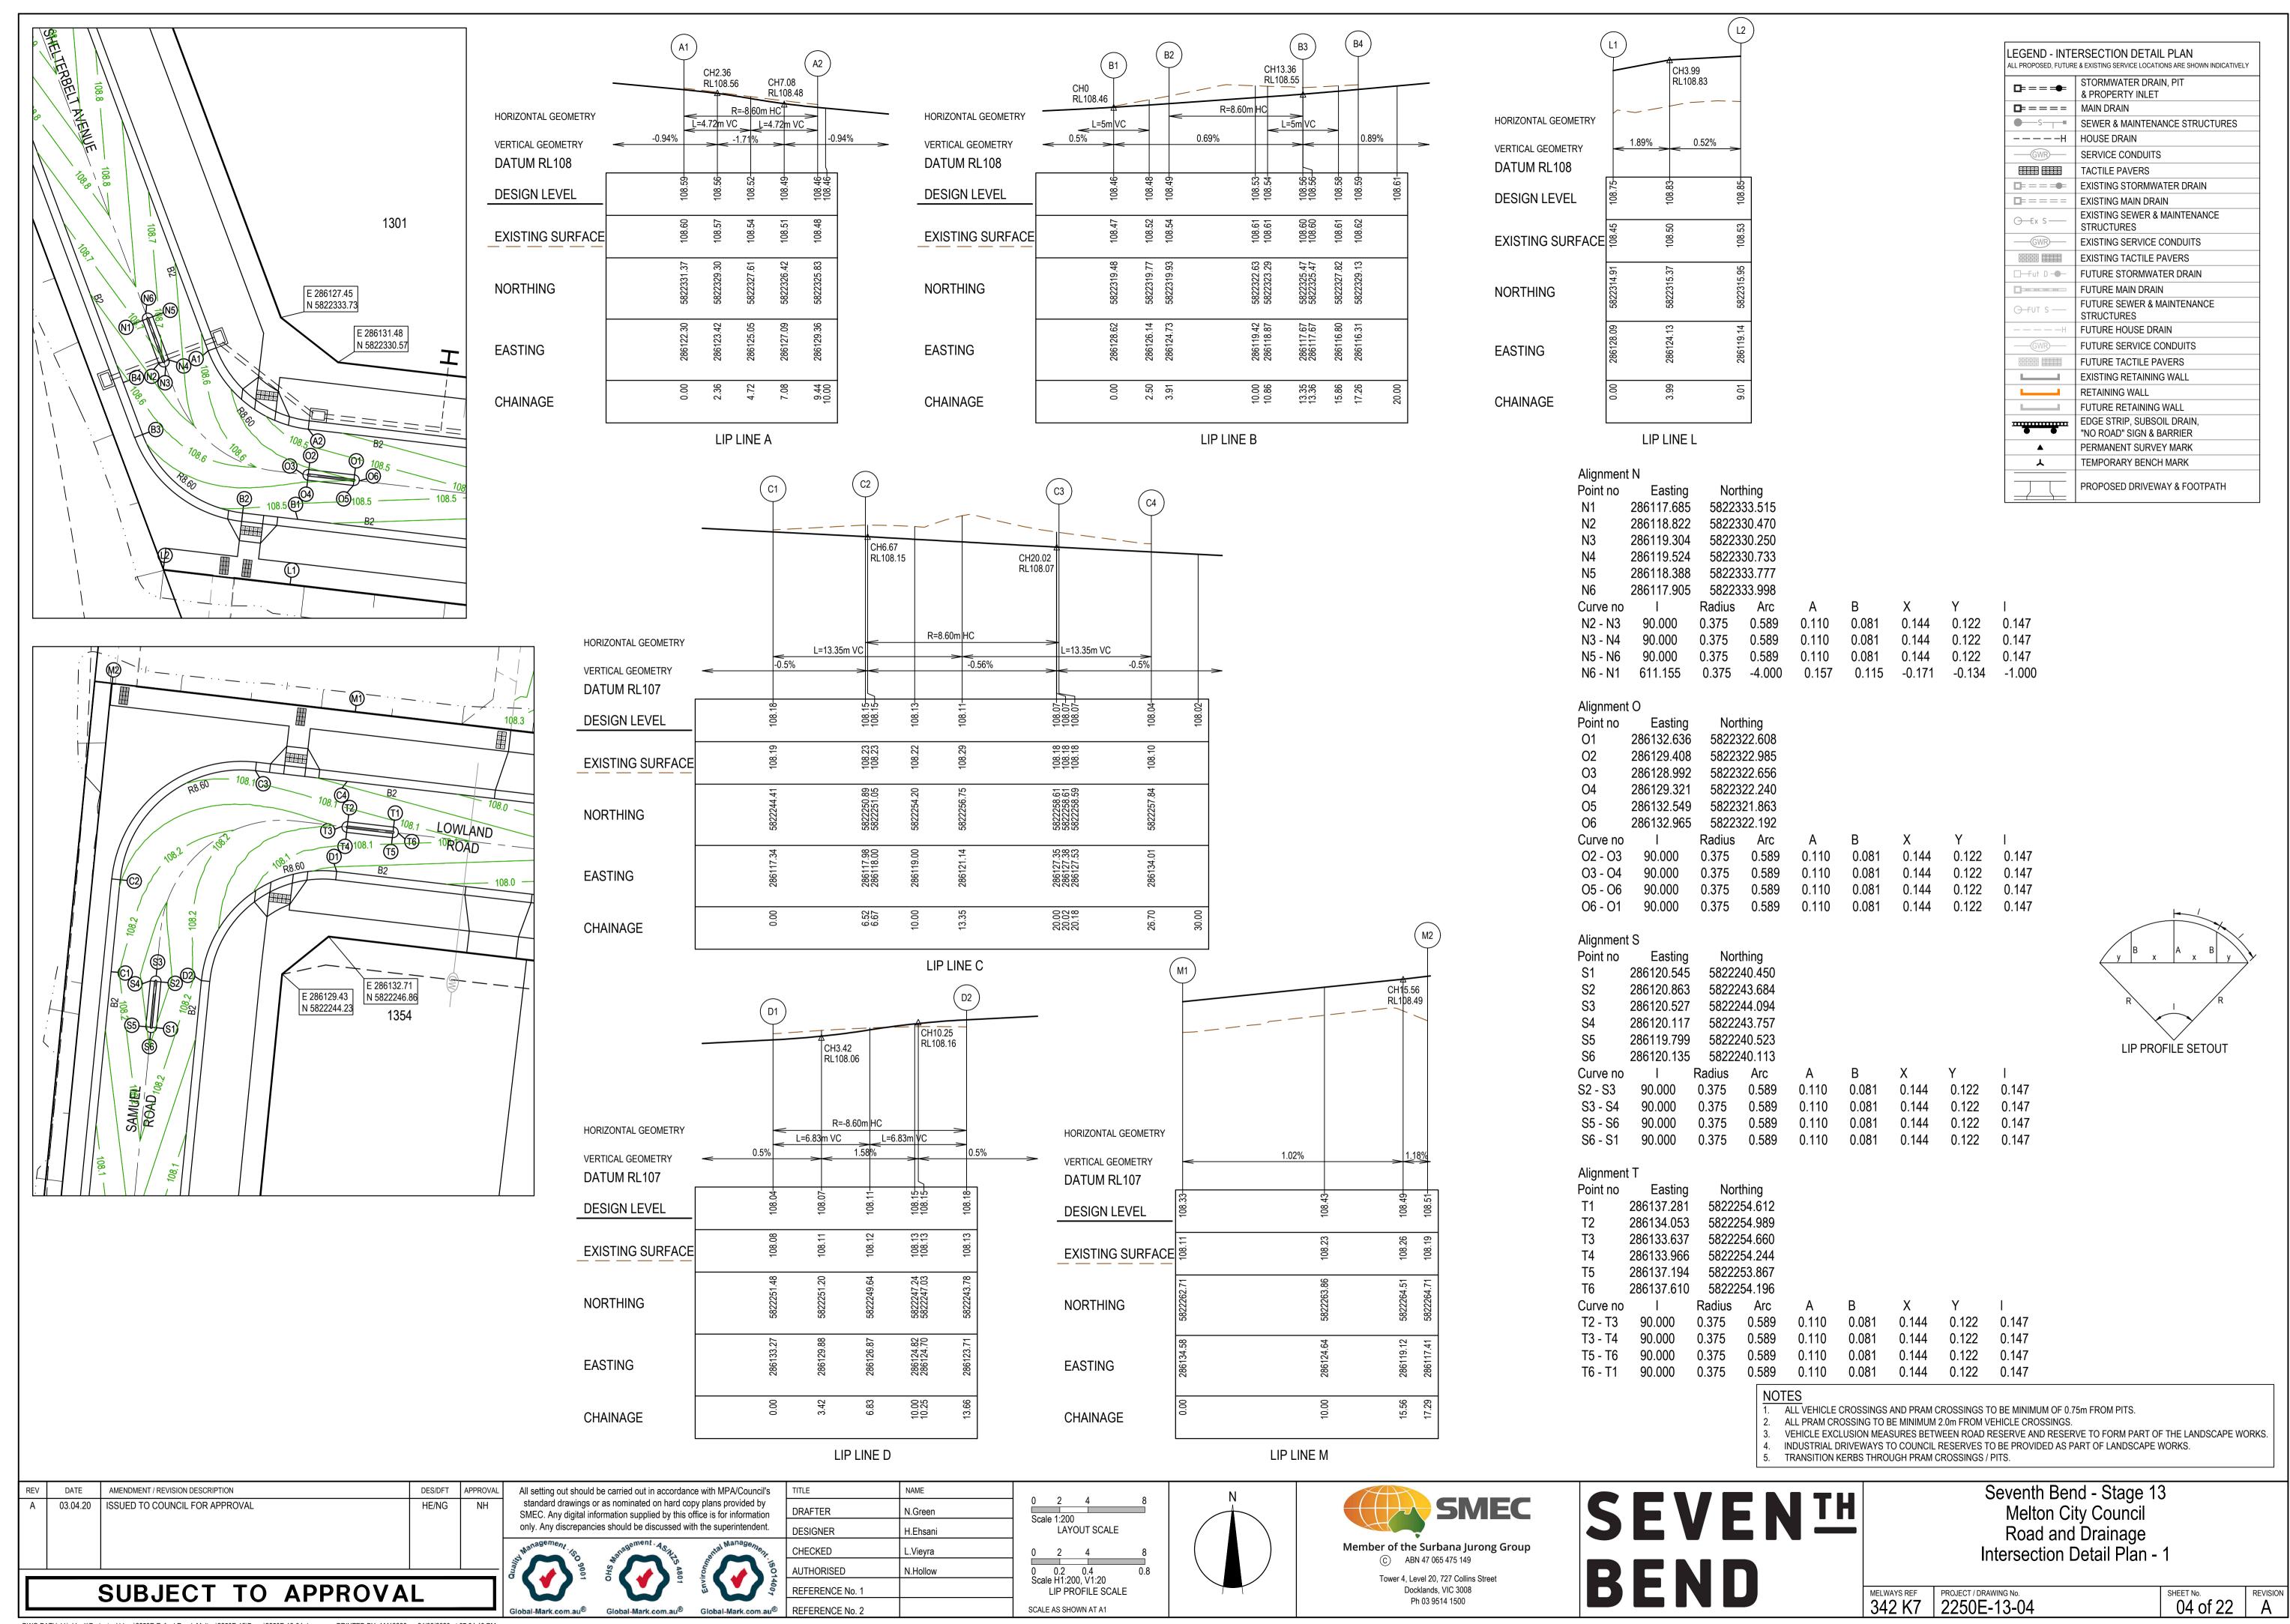

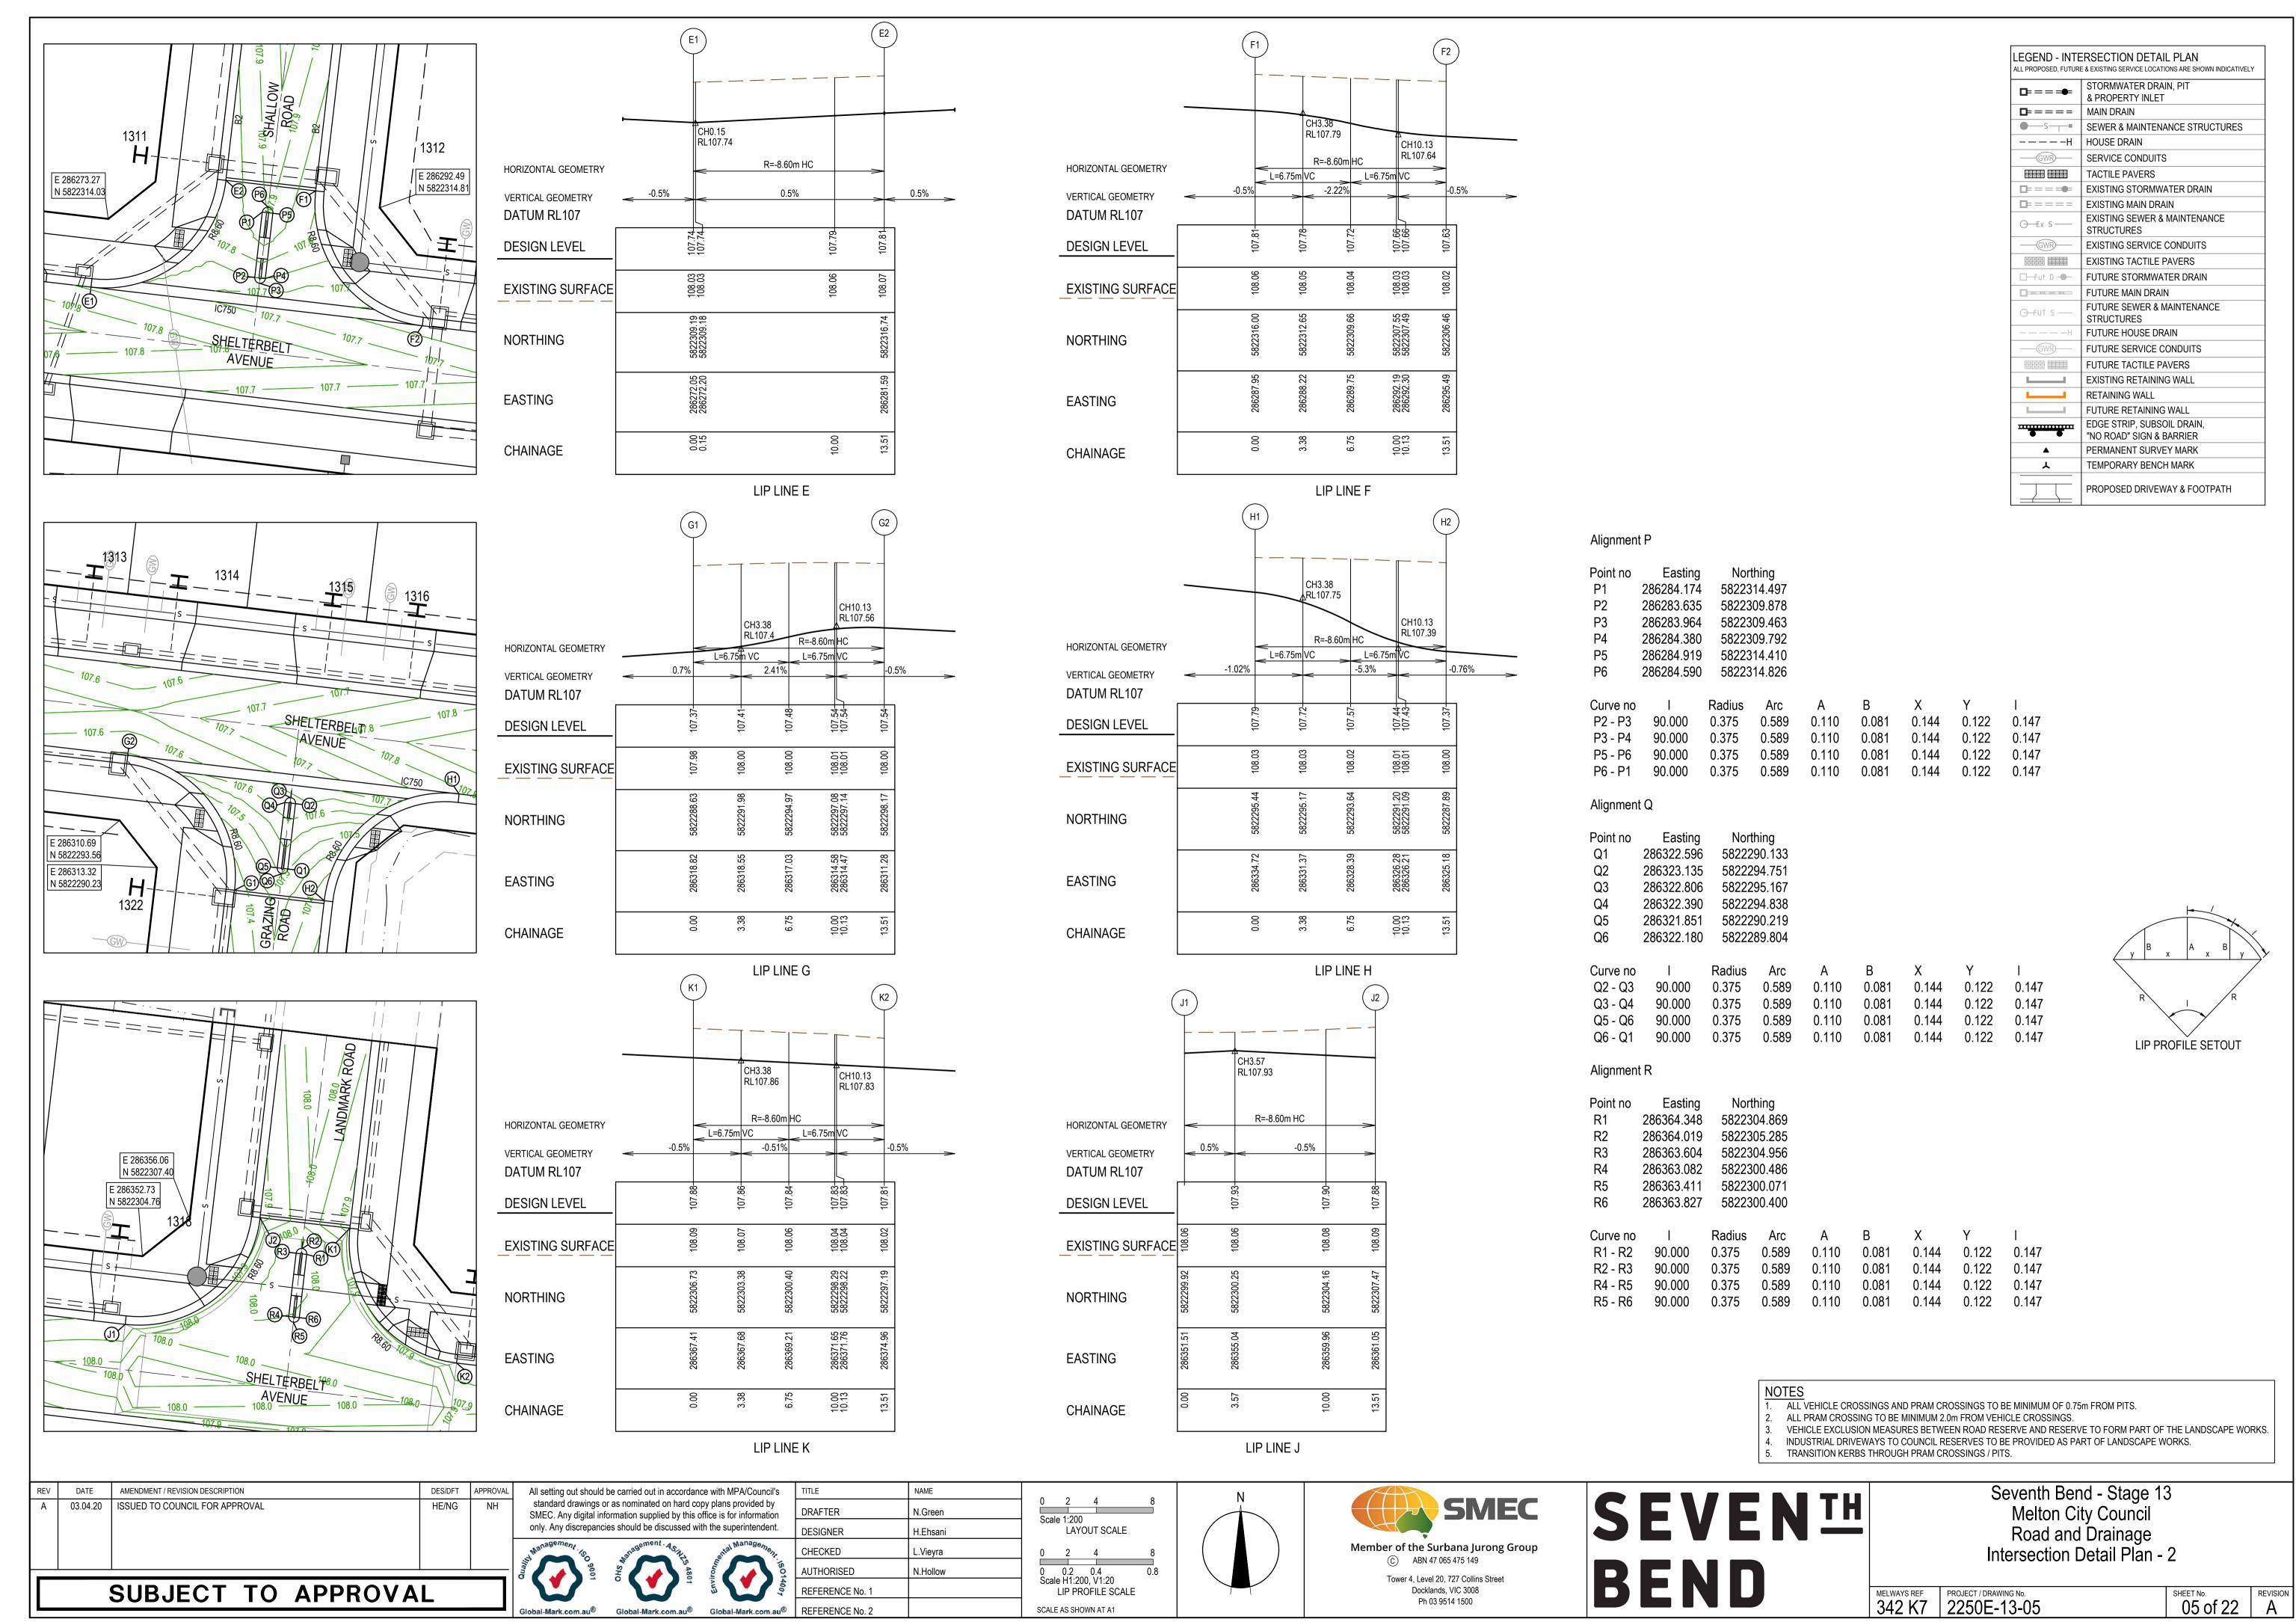

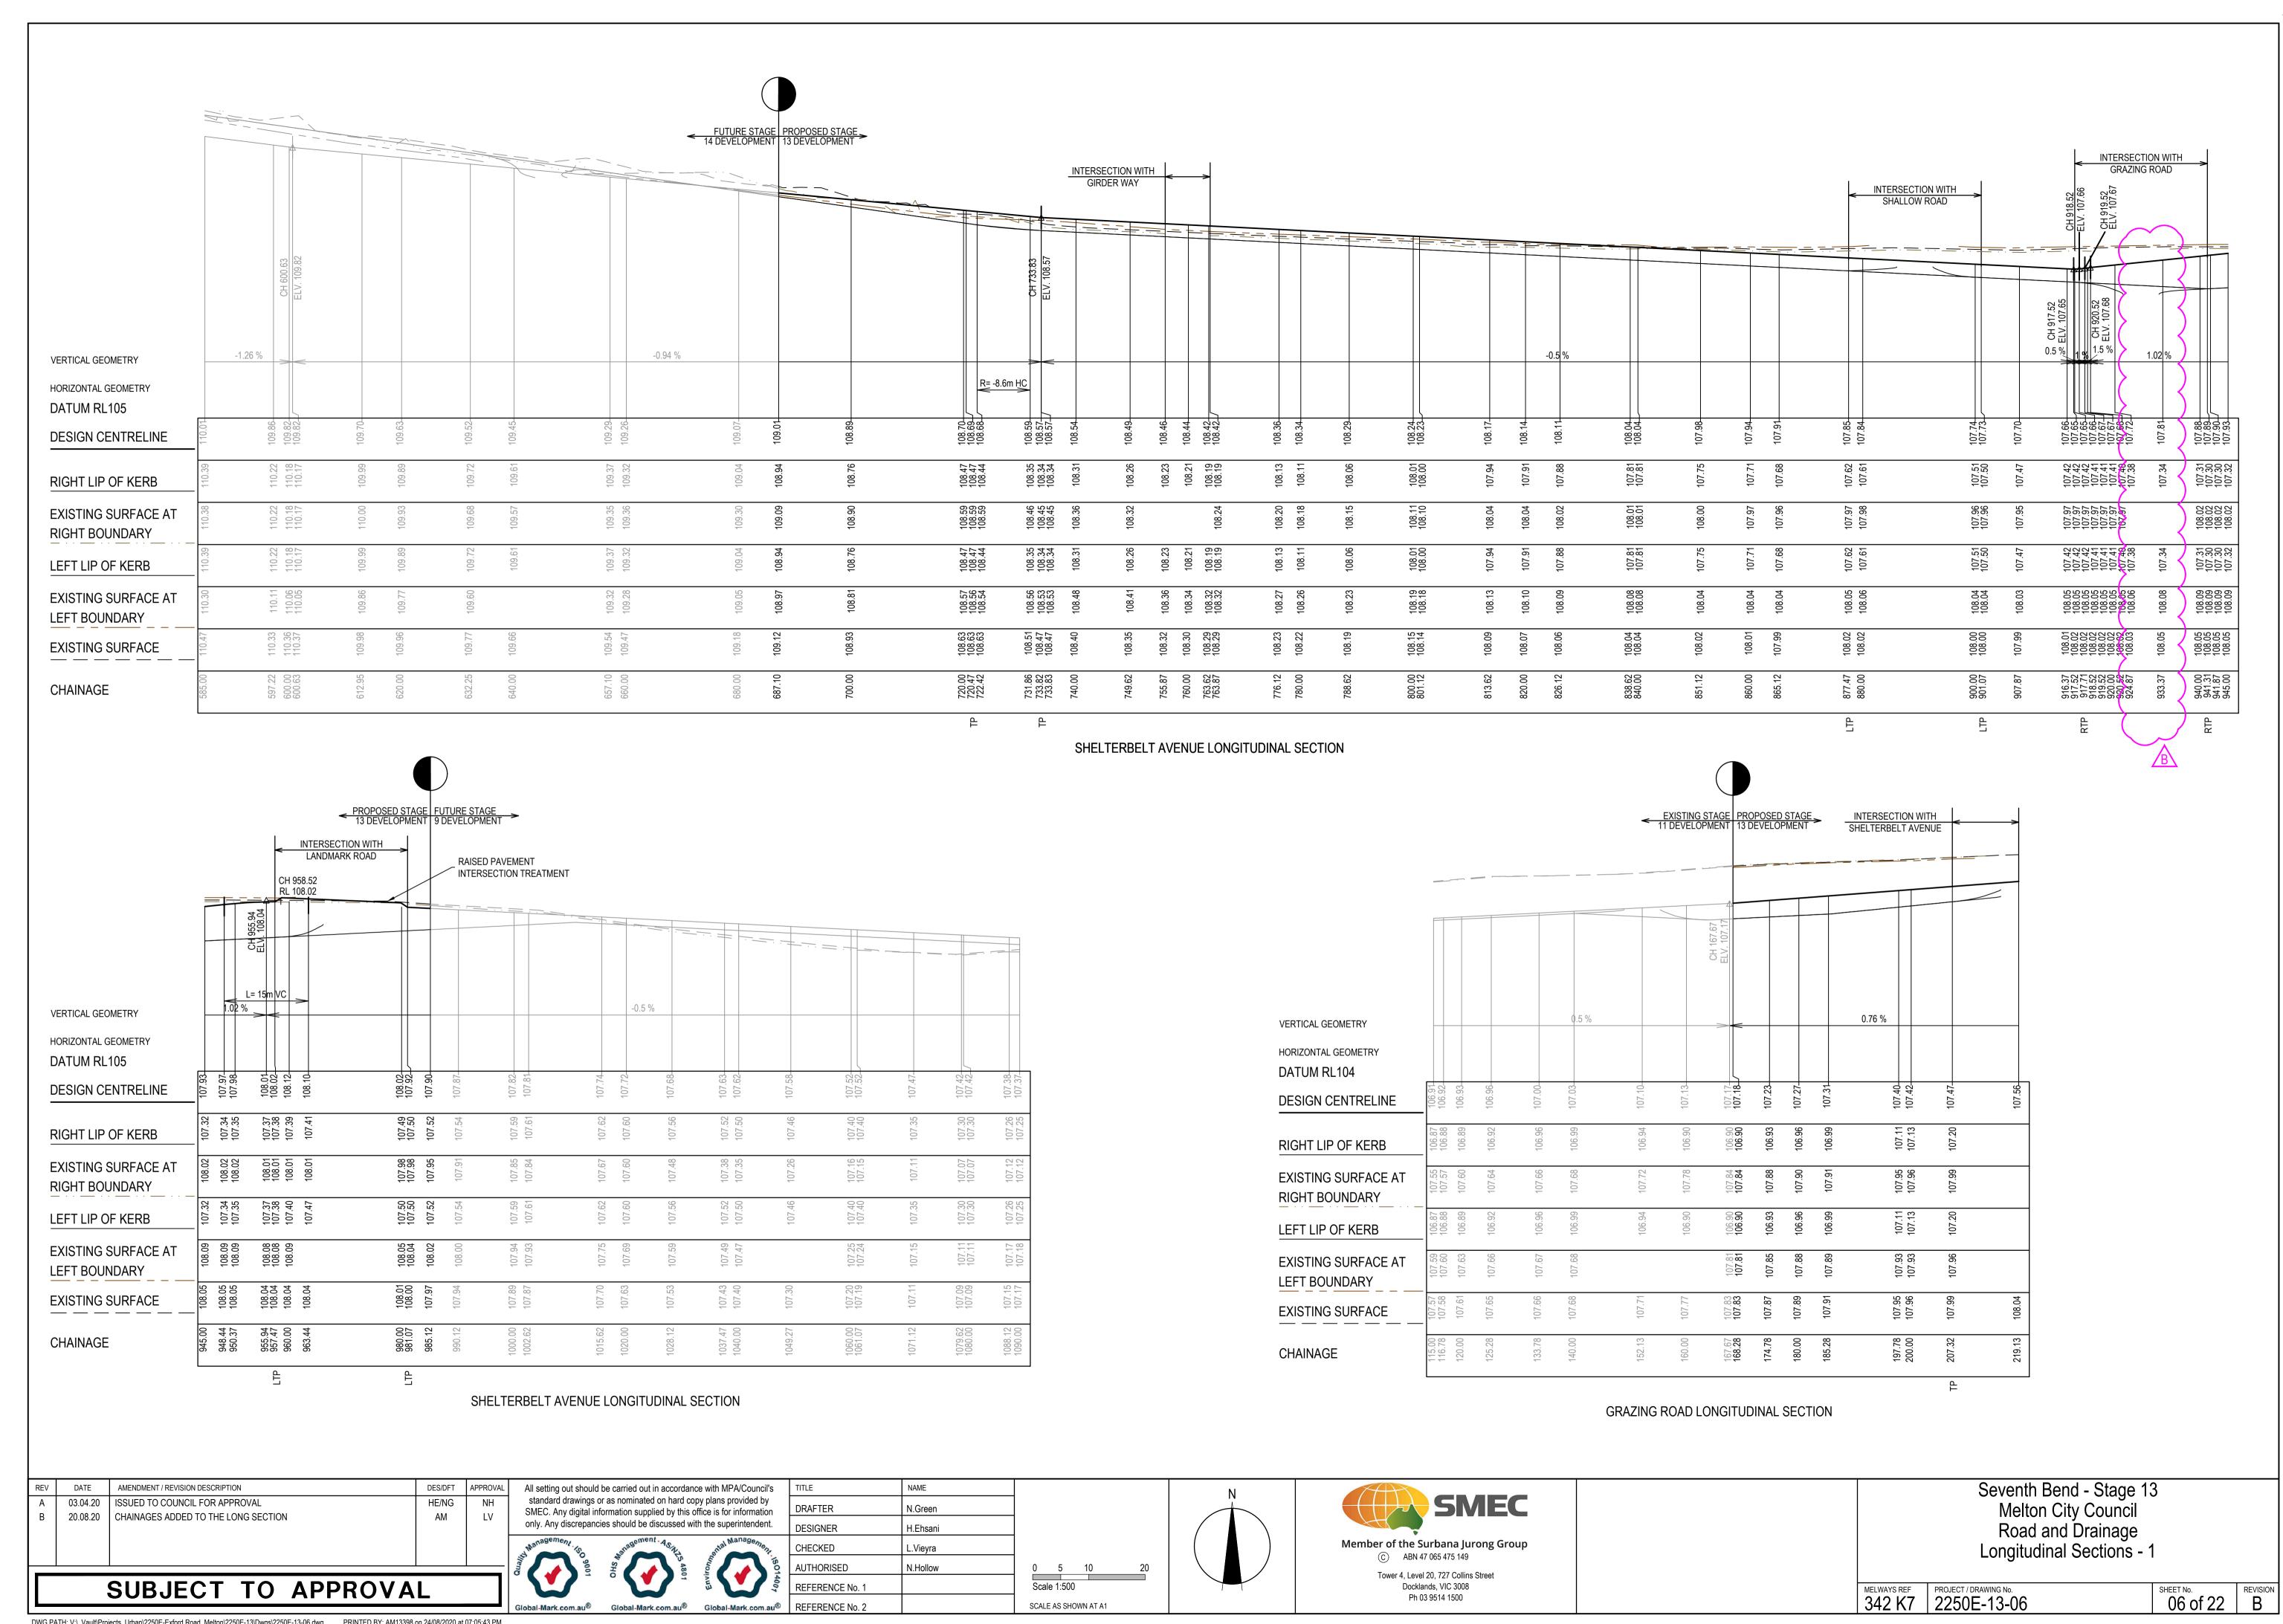




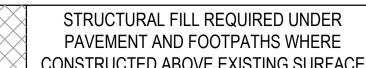

Ch 687.10 - Ch 826.12

SHEET No. REVISION B

MELWAYS REF PROJECT / DRAWING NO. 2250E-13-08

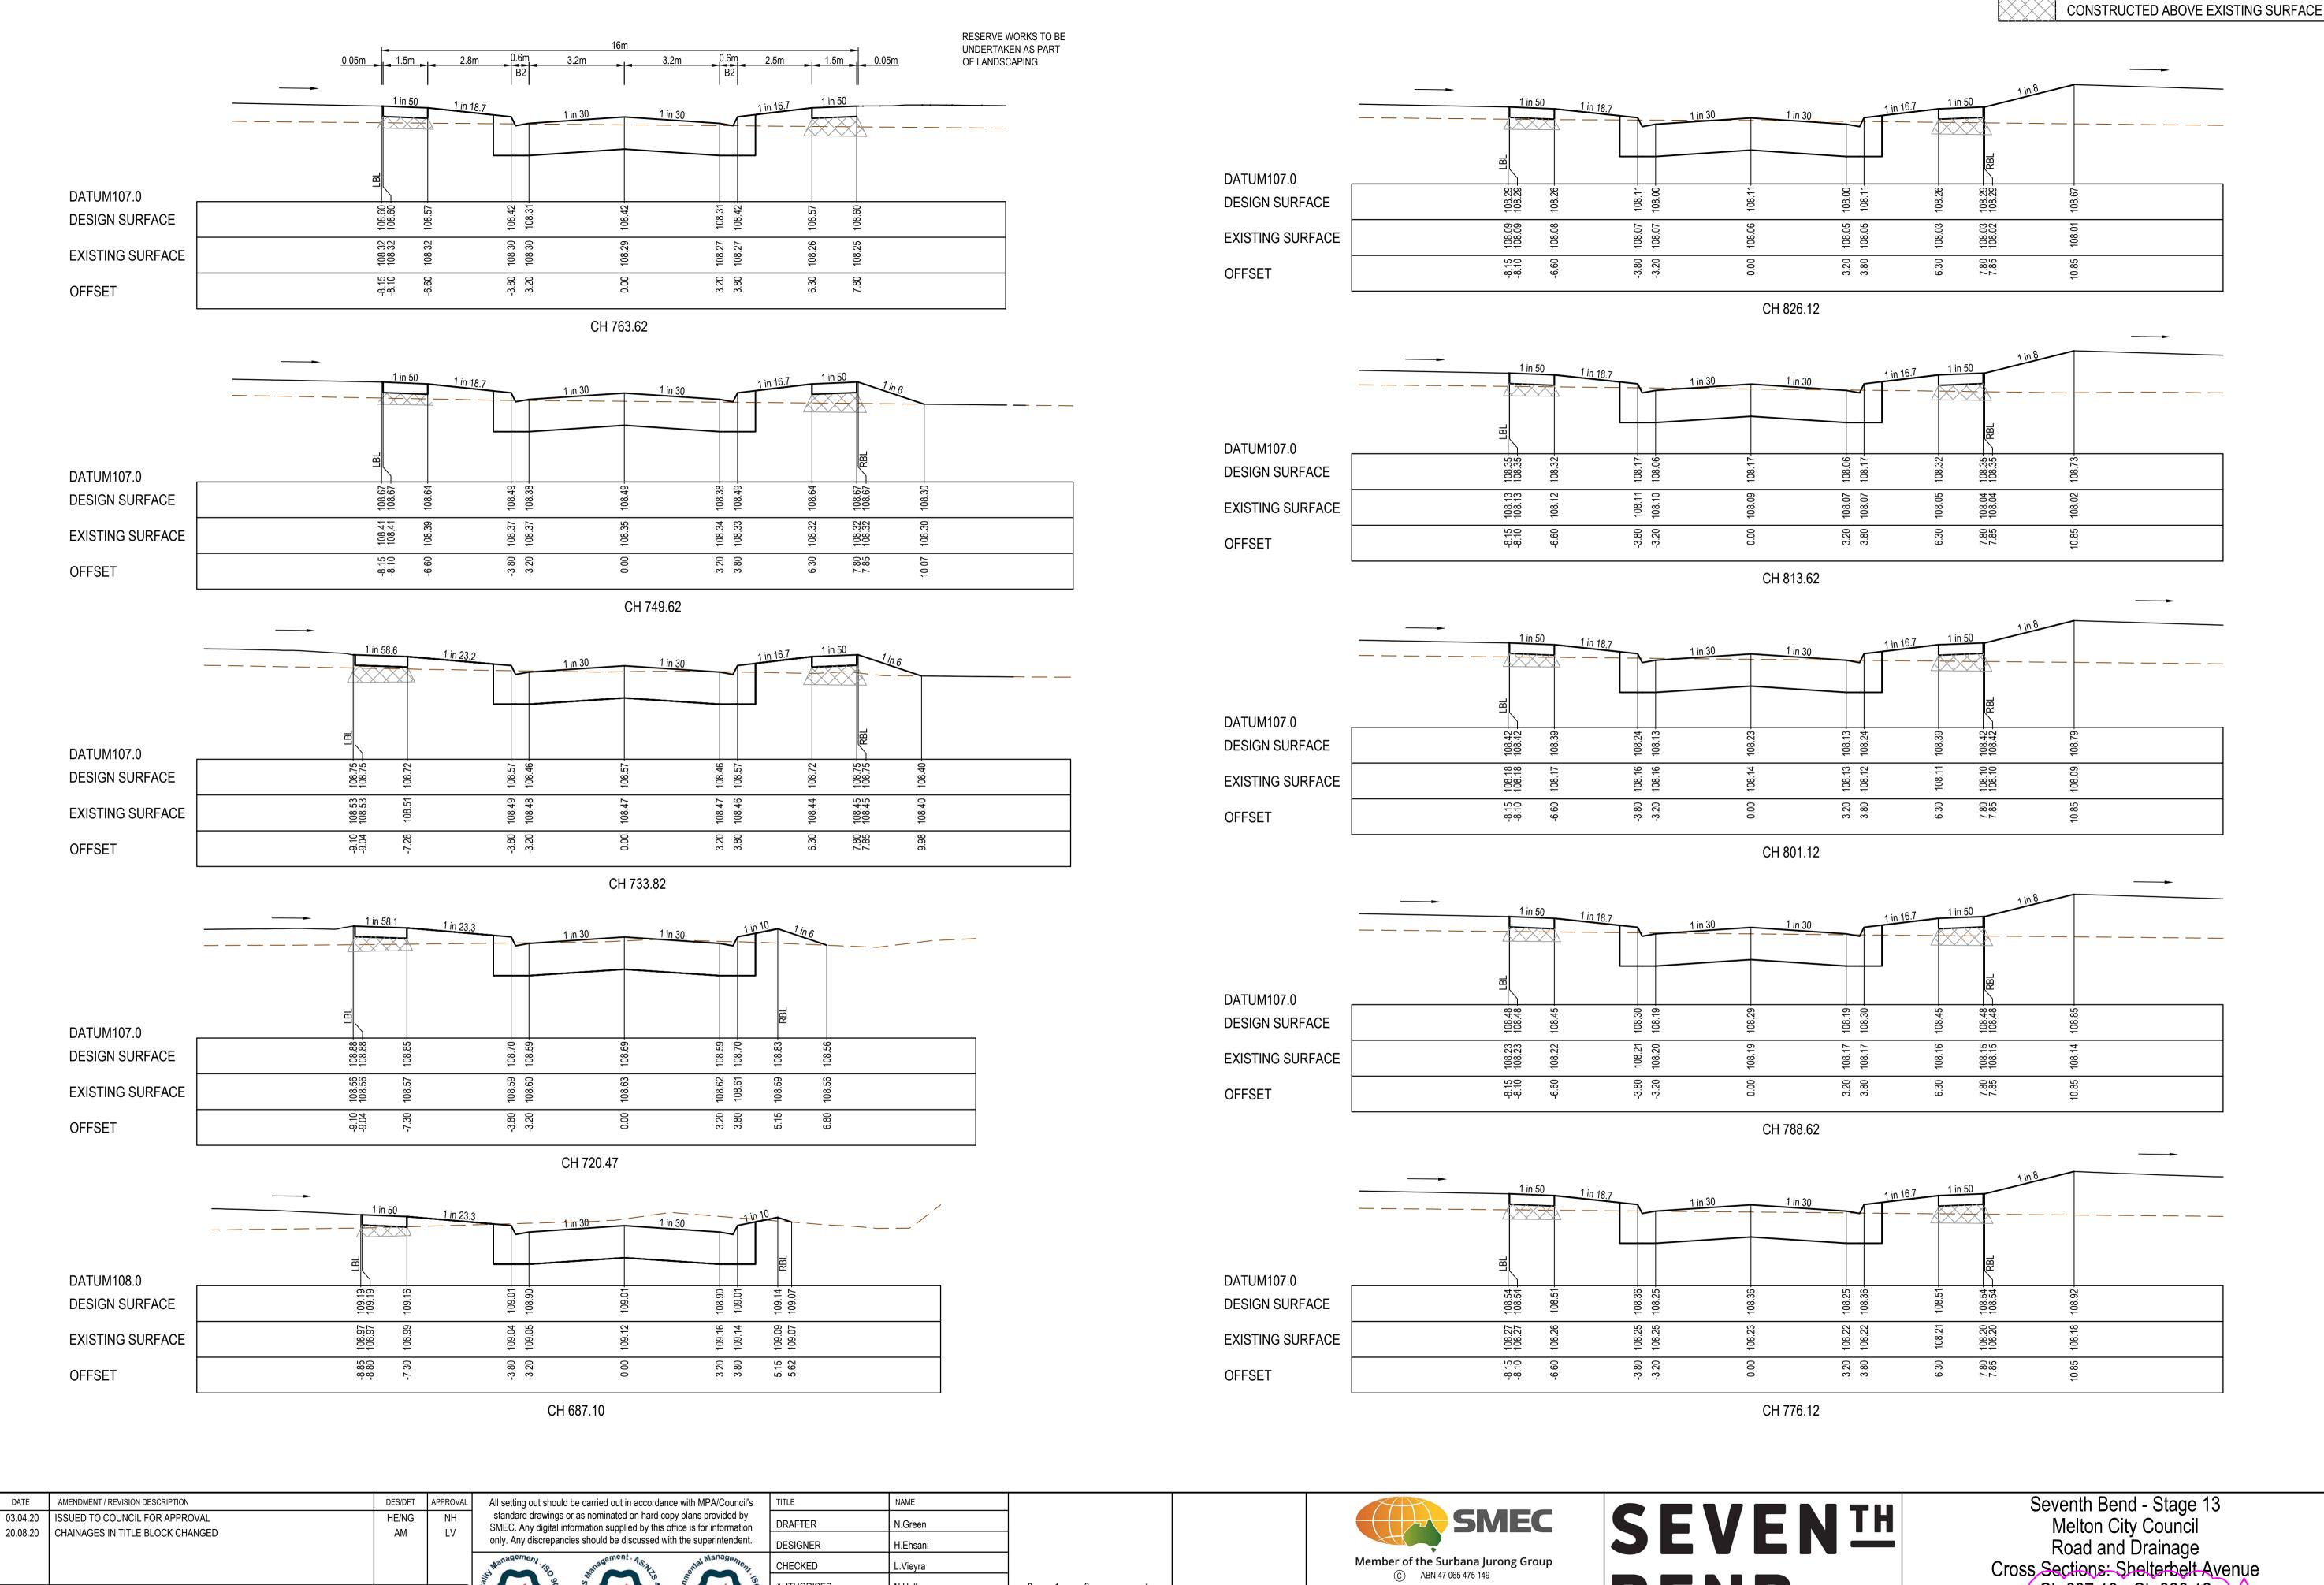

© ABN 47 065 475 149

Tower 4, Level 20, 727 Collins Street

Docklands, VIC 3008

Ph 03 9514 1500

BEND

L.Vieyra

N.Hollow

0 0.5 1 Scale H1:100, V1:50 SCALE AS SHOWN AT A1

AUTHORISED


REFERENCE No. 1

SUBJECT TO APPROVAL

Ch 838.62 - Ch 941.87

SHEET No. REVISION B

MELWAYS REF PROJECT / DRAWING No. 2250E-13-09

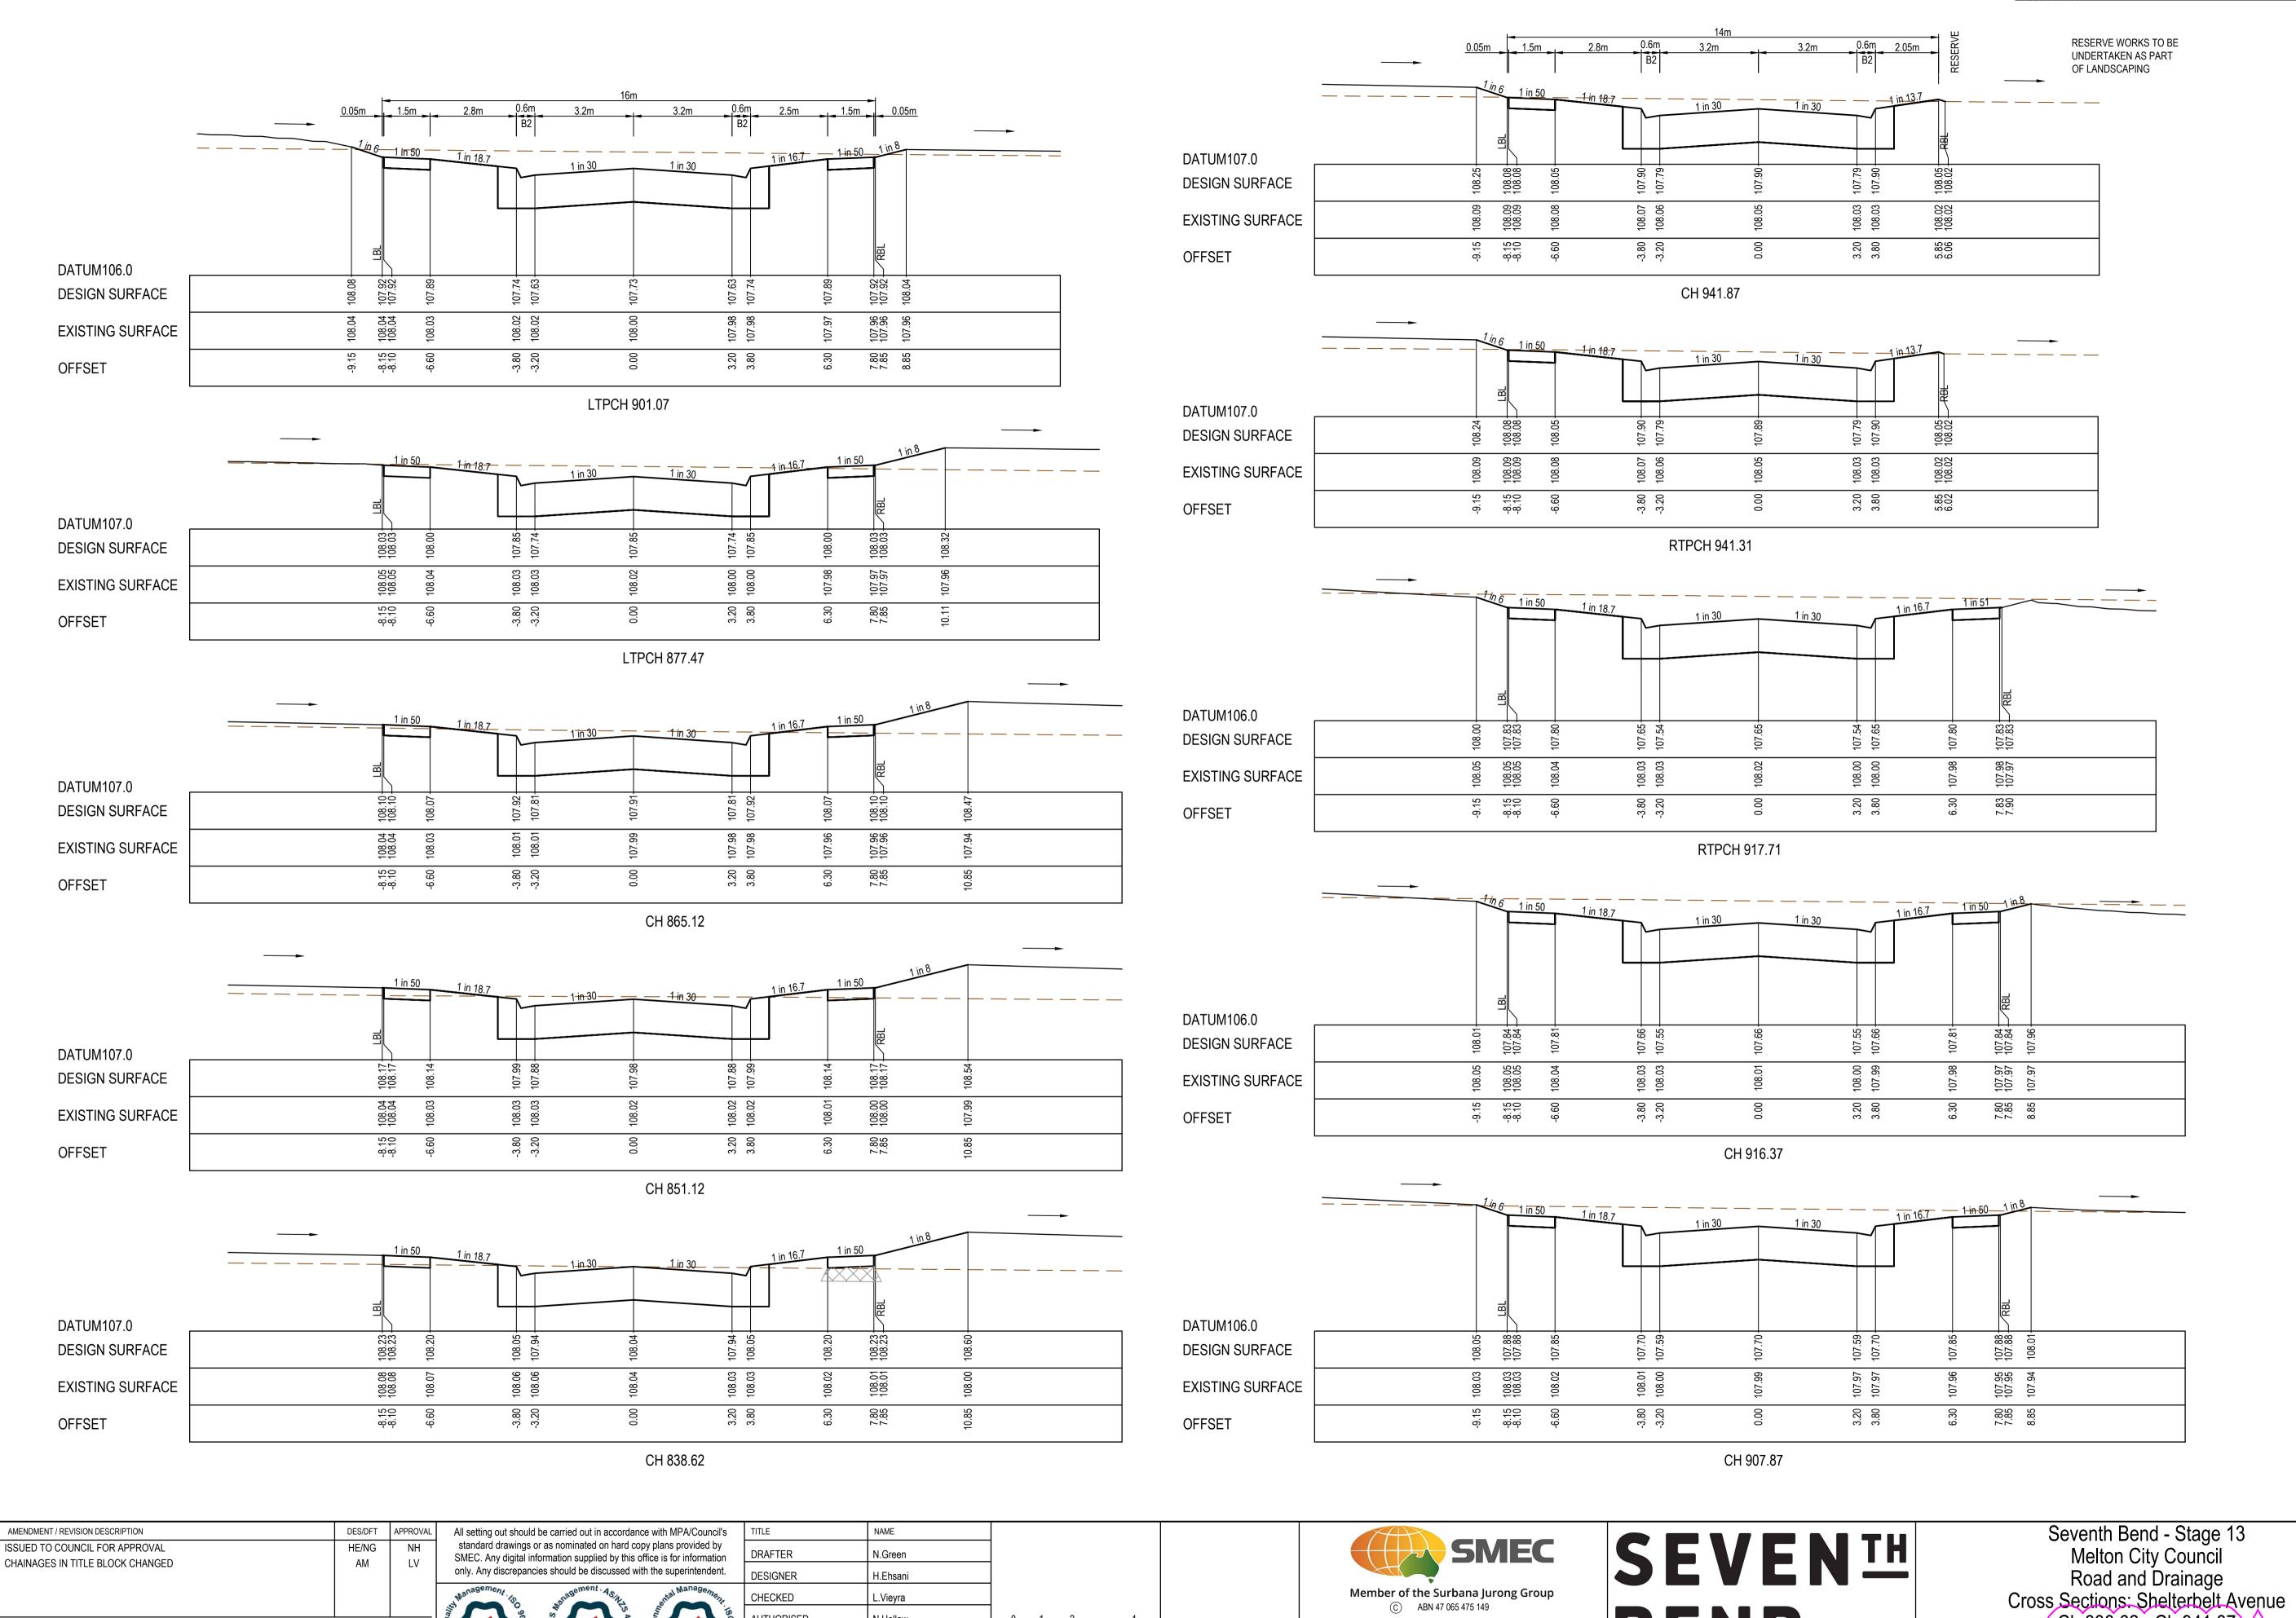

Member of the Surbana Jurong Group

Tower 4, Level 20, 727 Collins Street

Docklands, VIC 3008

Ph 03 9514 1500

BEND

© ABN 47 065 475 149

H.Ehsani

L.Vieyra


0 0.5 1 2 Scale H1:100, V1:50 SCALE AS SHOWN AT A1


AUTHORISED

REFERENCE No. 1

SUBJECT TO APPROVAL

20.08.20

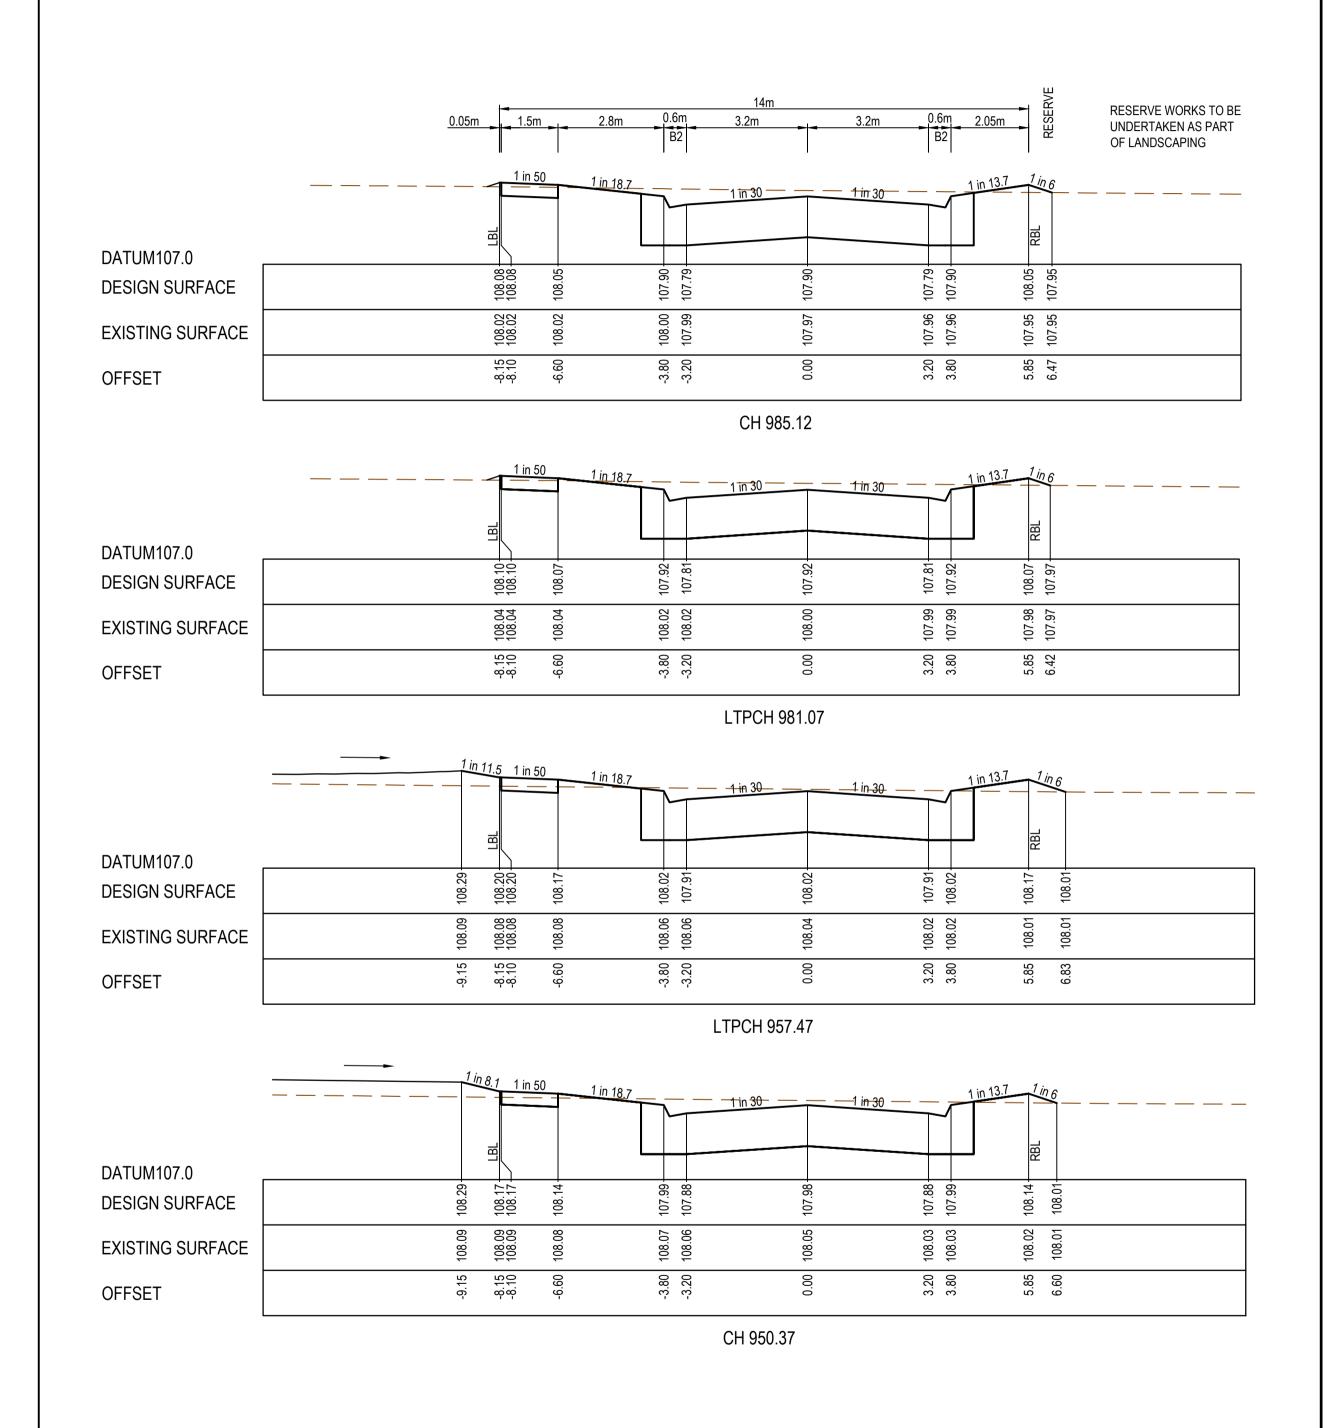

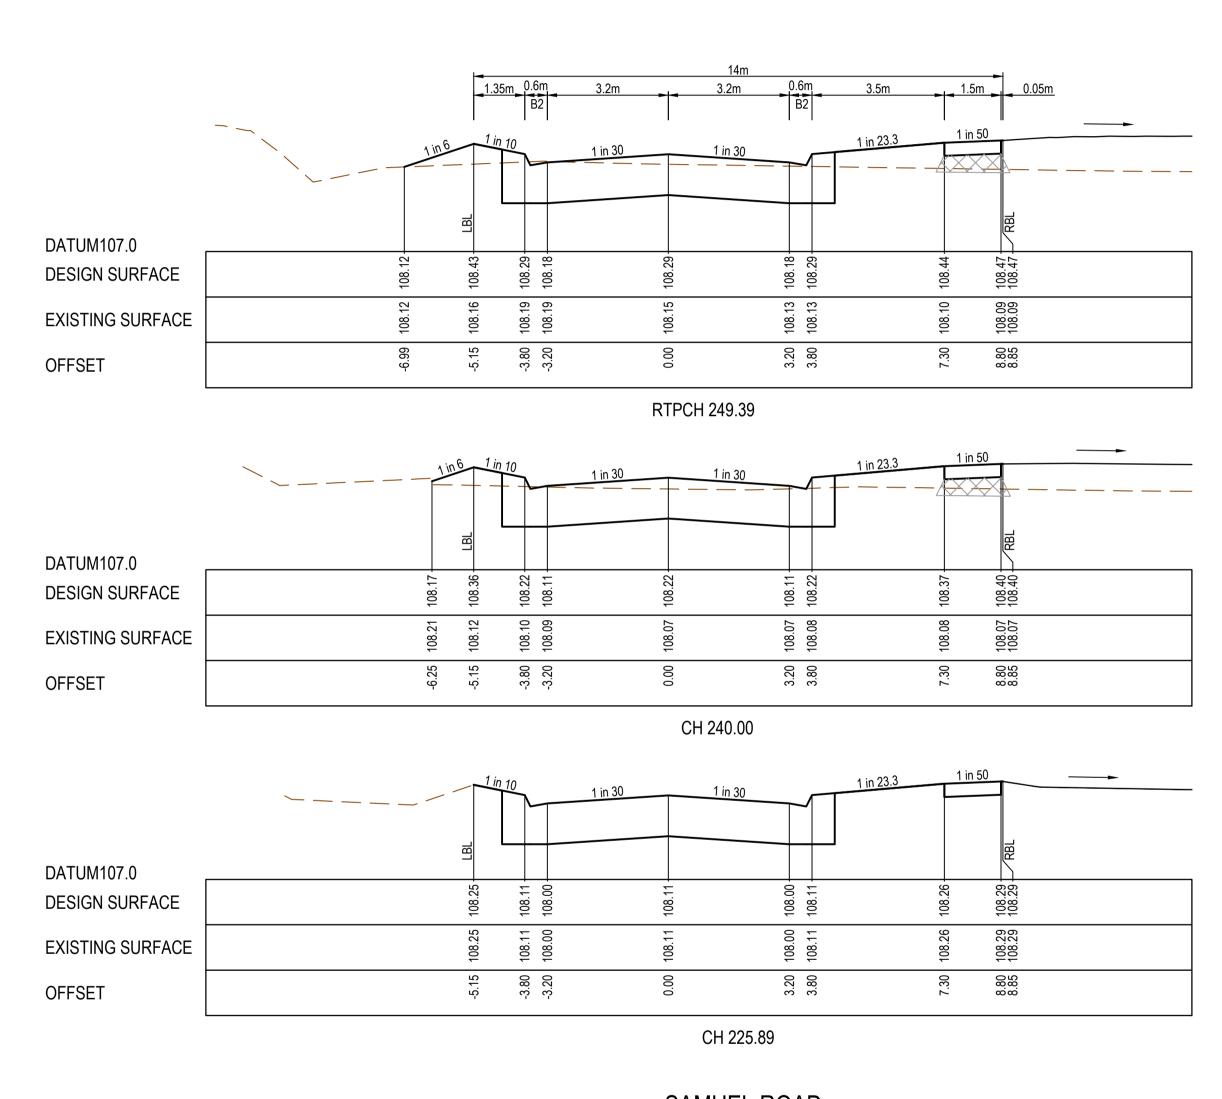



SAMUEL ROAD

SHELTERBELT AVENUE

В	20.08.20	CHAINAGES IN TITLE BLOCK CHANGED	AM	LV
		SUBJECT TO APPROVA	L	

All setting out should be carried out in accordance with MPA/Council's standard drawings or as nominated on hard copy plans provided by SMEC. Any digital information supplied by this office is for information only. Any discrepancies should be discussed with the superintendent.

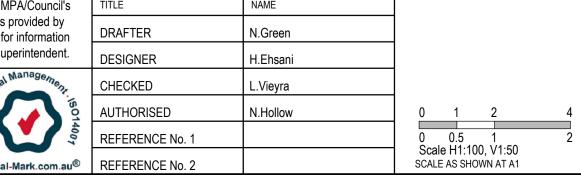

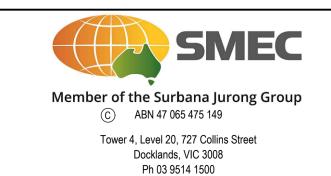

SEVENT BEND

Seventh Bend - Stage 13

Melton City Council


Road and Drainage


Cross Sections: Shelterbelt Avenue Ch 950.37 - Ch 985.12


and Samuel Road Ch 225.89 - Ch 249.39

and Samuel Road Ch 225.89 - Ch 249.39

MELWAYS REF PROJECT / DRAWING No. SHEET No. REVISION BY 10 of 22 B

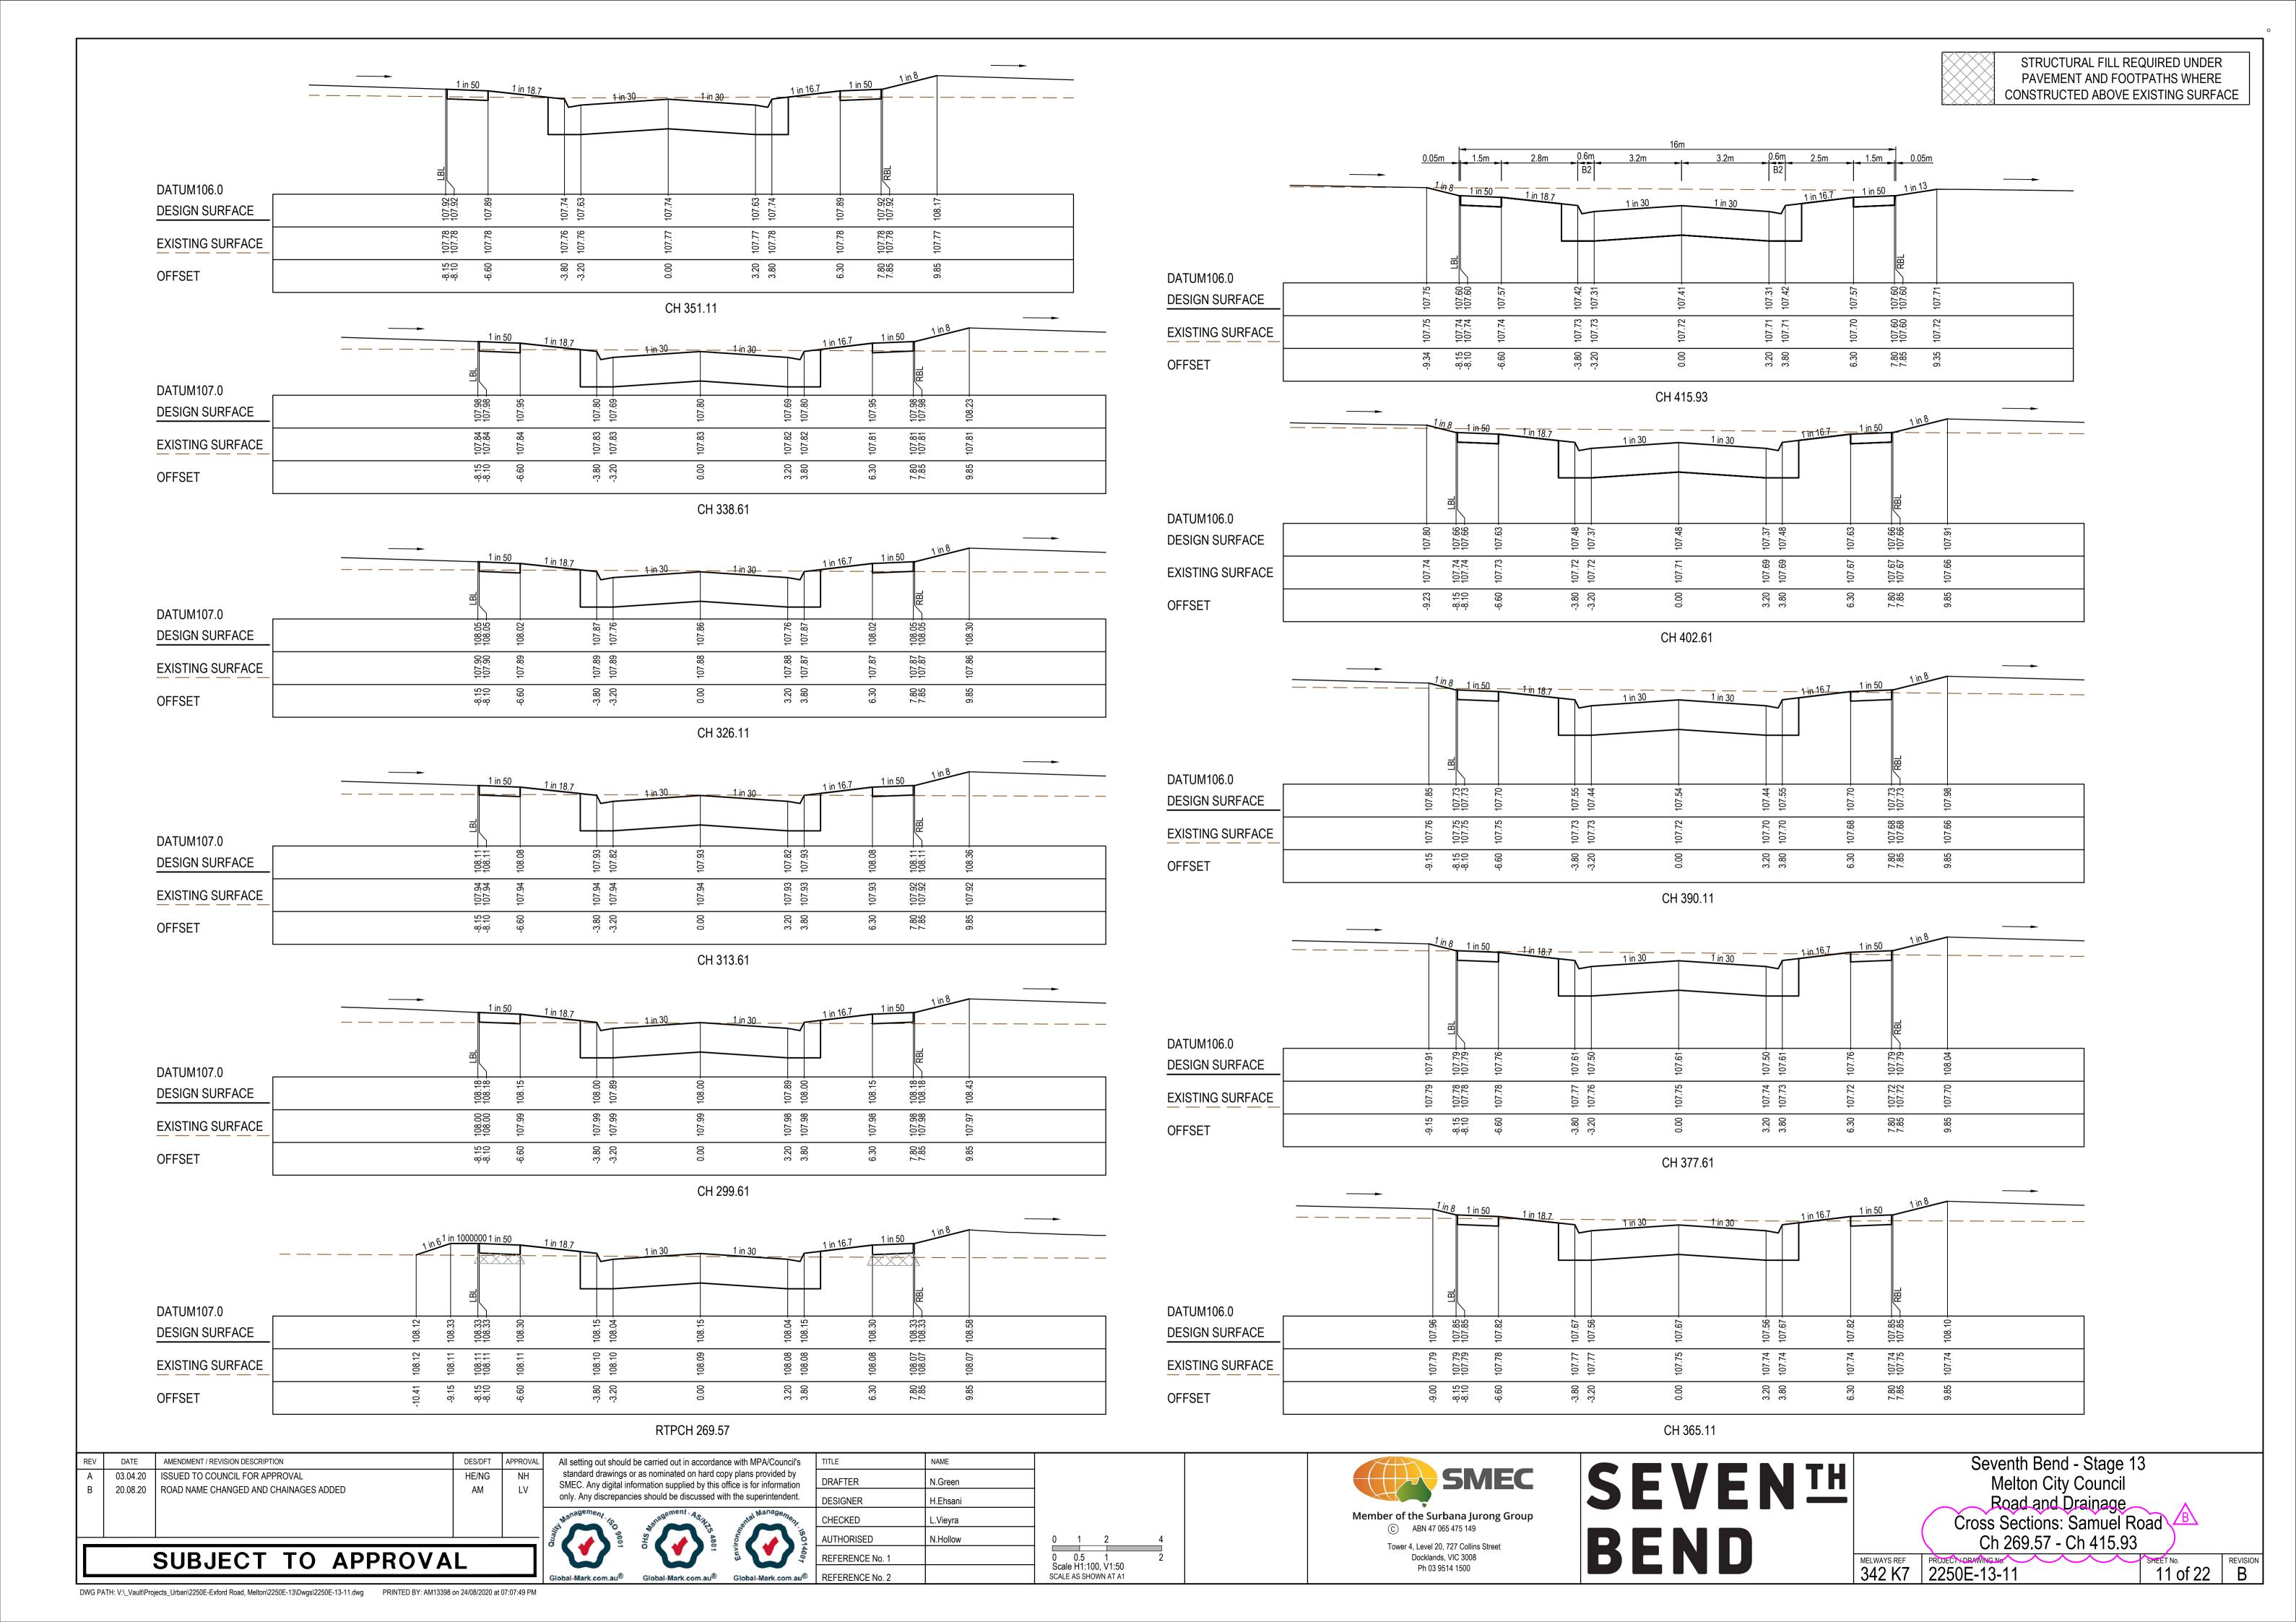

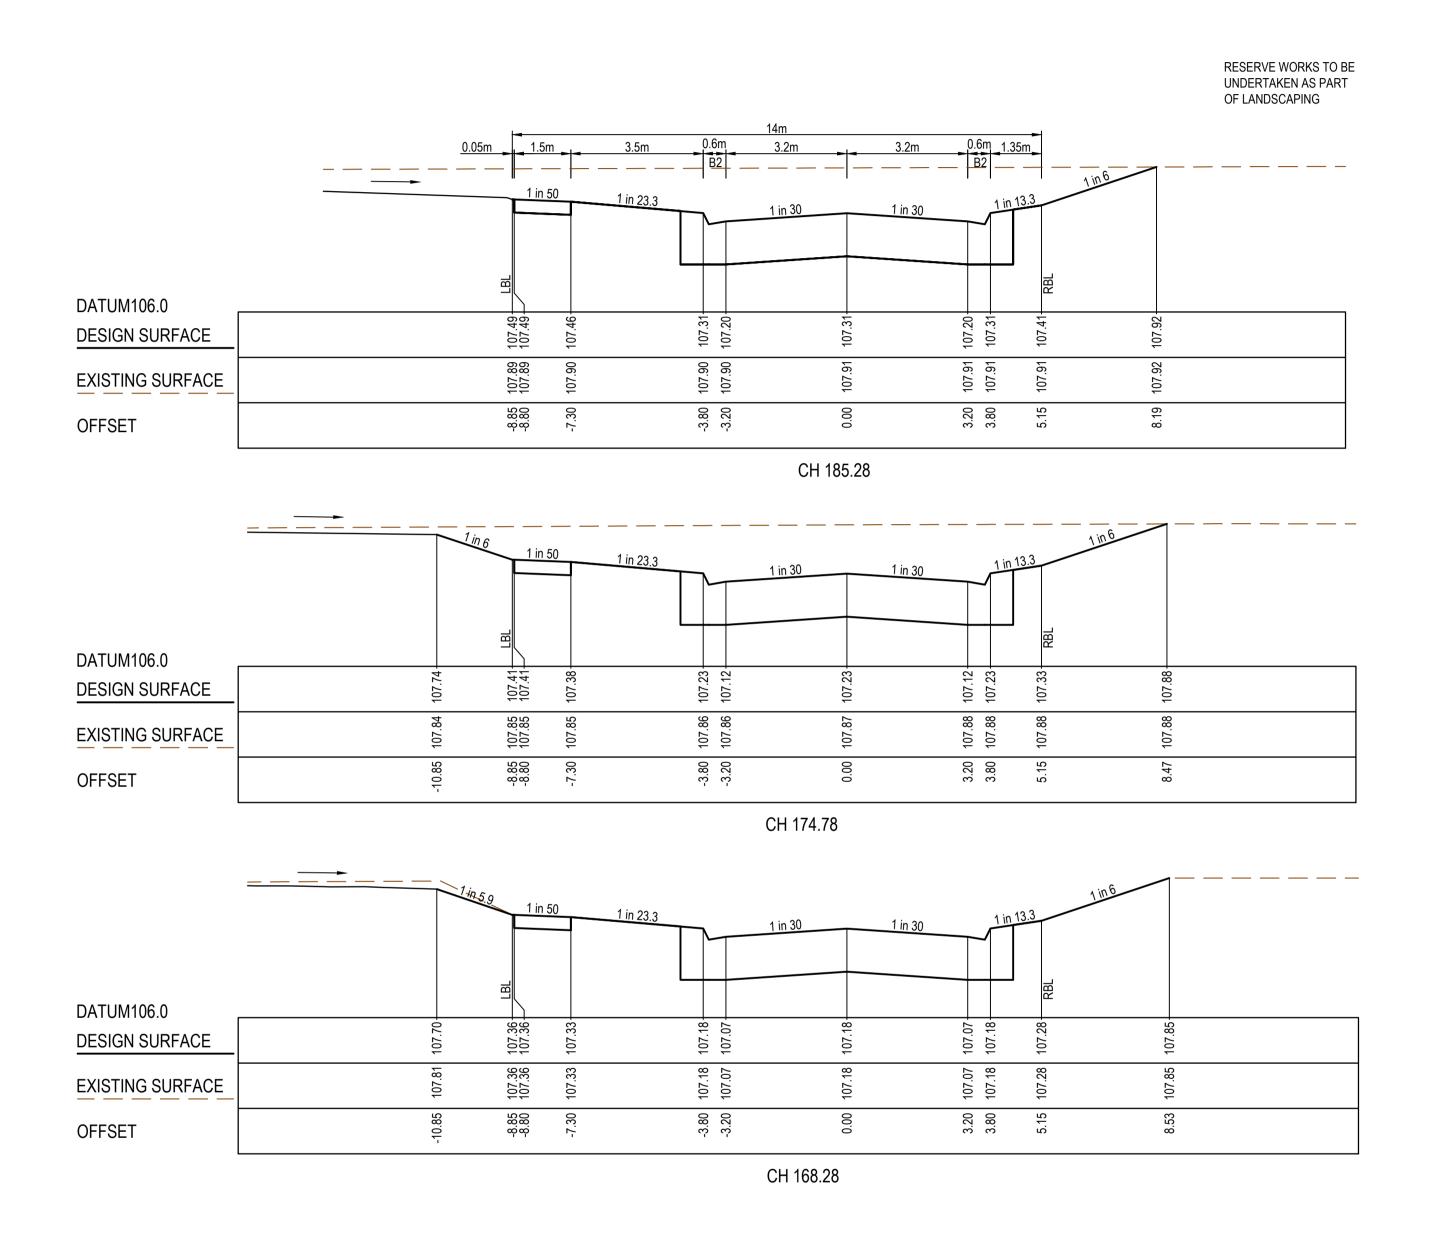

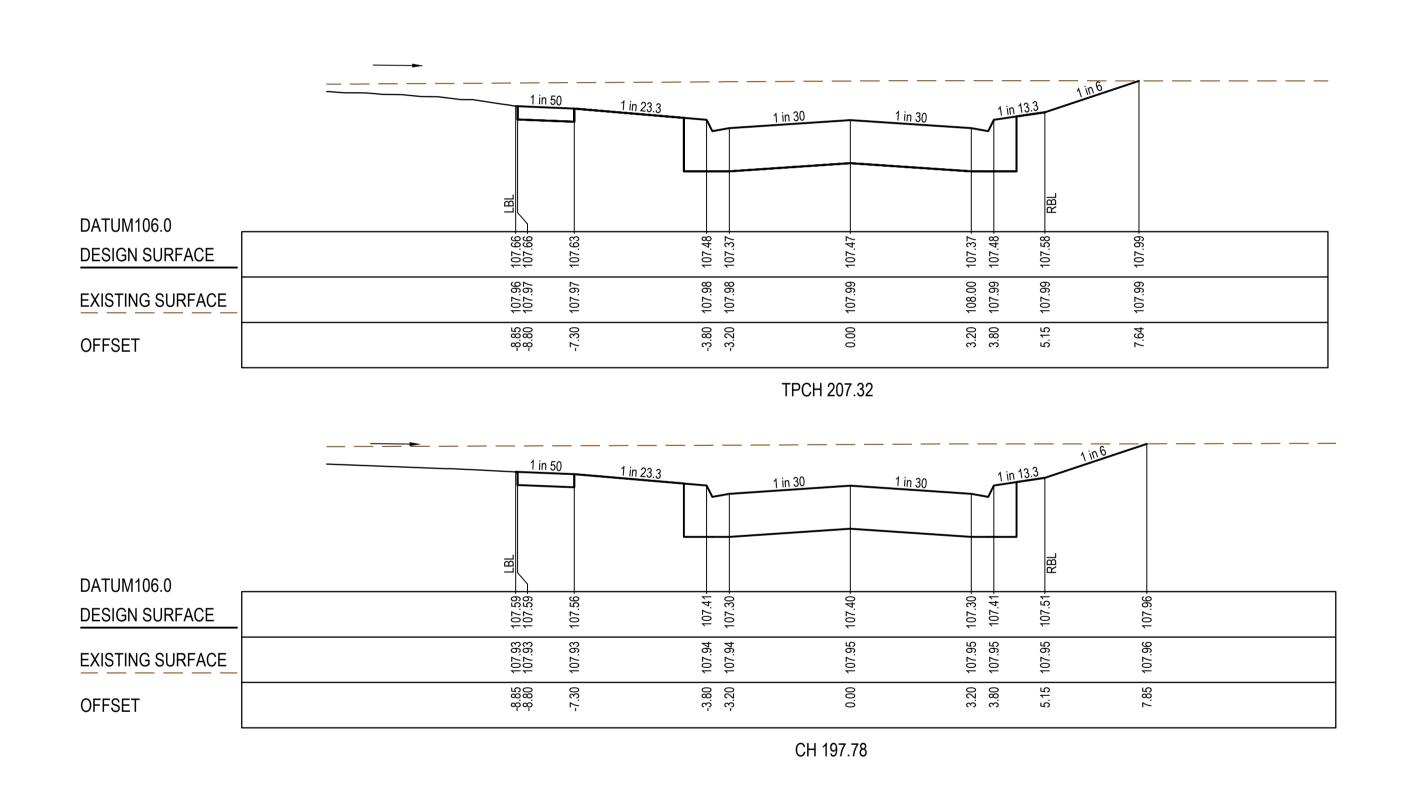


	(SUBJECT	TO	APPROVA	L

AMENDMENT / REVISION DESCRIPTION

ISSUED TO COUNCIL FOR APPROVAL

A 03.04.20

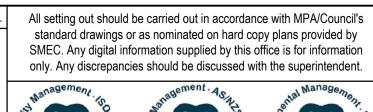

I on hard copy plans provided by ied by this office is for information	DRAF
iscussed with the superintendent.	DESI
1. ASINT	CHEC
488	AUTH
100 ₇	REFE

ıncil's	TITLE	NAME	
d by nation	DRAFTER	N.Green	
ident.	DESIGNER	H.Ehsani	
ment	CHECKED	L.Vieyra	
ment. 19014007	AUTHORISED	N.Hollow	0 1 2
4007	REFERENCE No. 1		0 0.5 1 Scale H1:100, V1:50
om.au®	REFERENCE No. 2		SCALE AS SHOWN AT A1



SEVENTH BEND


Seventh Bend - Stage 13

Melton City Council

Road and Drainage


Cross Sections: Grazing Road

MELWAYS REF | PROJECT / DRAWING No. | 2250E-13-12 SHEET No. REVISION A

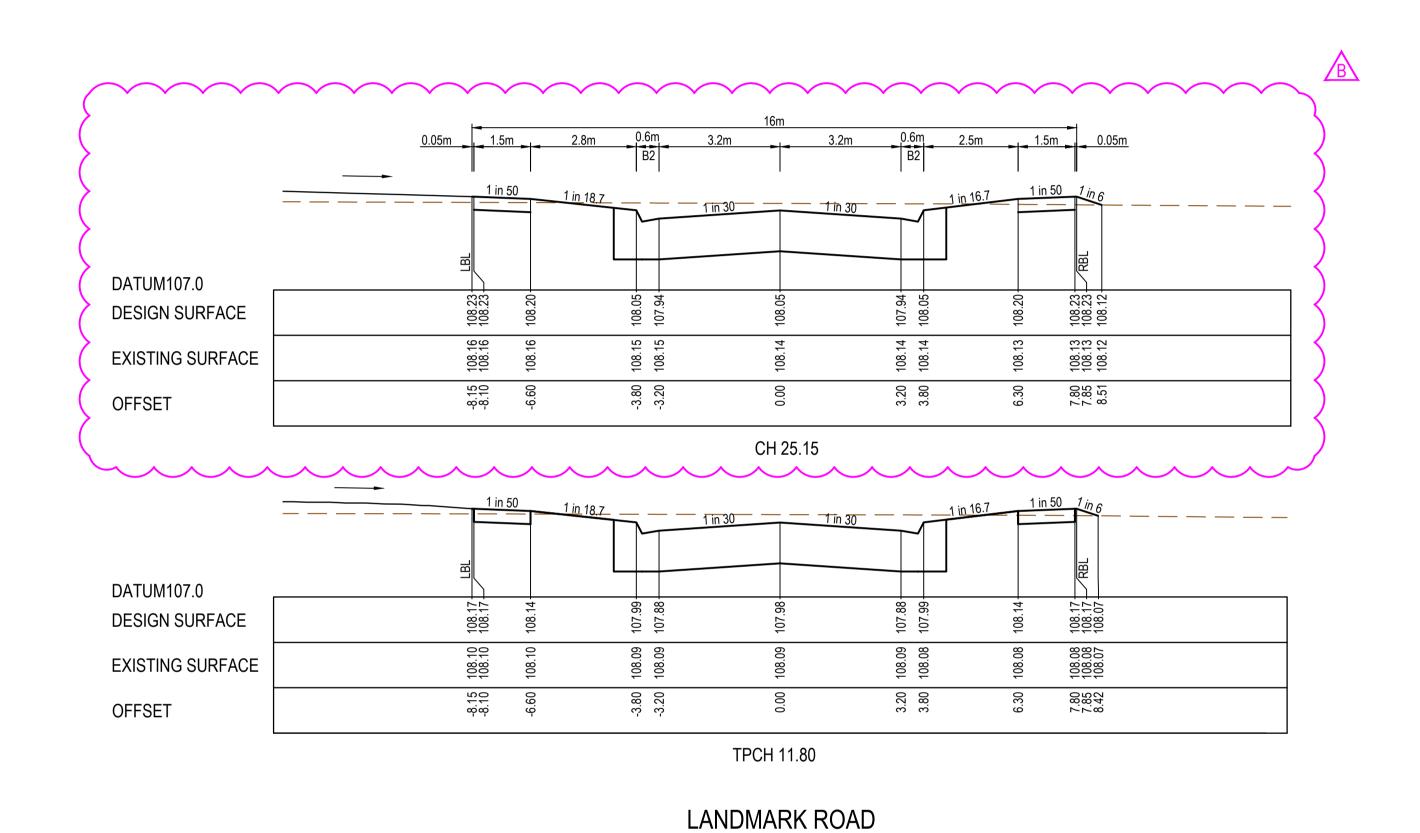

DATUM107.0 108.26 108.26 108.20 **DESIGN SURFACE** 108.22 108.22 108.22 108.20 108.20 108.20 **EXISTING SURFACE** -8.15 -8.10 -3.80 3.20 OFFSET CH 40.15 DATUM107.0 9 $\infty \infty$ **DESIGN SURFACE** 108. 108. 28 98. 107 108.13 108.13 $\frac{\omega}{\omega}$ **EXISTING SURFACE** 868 108. 108. -3.80 3.20 -8.15 -8.10 7.80 7.85 OFFSET CH 24.15 DATUM107.0 108.10 108.10 108.12 108.12 92 **DESIGN SURFACE** 108.07 108.07 108.06 108.06 108.06 108.06 108.07 108.07 **EXISTING SURFACE** -8.15 -8.10 -3.80 3.20 3.80 7.80 7.85 OFFSET TPCH 11.80

SHALLOW ROAD

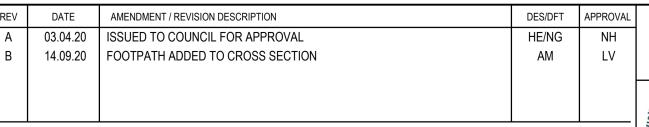

All setting out should be carried out in accordance with MPA/Council's standard drawings or as nominated on hard copy plans provided by SMEC. Any digital information supplied by this office is for information only. Any discrepancies should be discussed with the superintendent.

DESIGNATION OF THE COUNCIL STANDARD OF

with MPA/Council's	TITLE	NAME
olans provided by e is for information	DRAFTER	N.Green
he superintendent.	DESIGNER	H.Ehsani
ental Management	CHECKED	L.Vieyra
Management SO14007	AUTHORISED	N.Hollow
4007	REFERENCE No. 1	
Global-Mark.com.au®	REFERENCE No. 2	

0 0.5 1 Scale H1:100, V1:50 SCALE AS SHOWN AT A1 Member of the Surbana Jurong Group

© ABN 47 065 475 149

Tower 4, Level 20, 727 Collins Street
Docklands, VIC 3008
Ph 03 9514 1500

SEVENTH BEND Seventh Bend - Stage 13

Melton City Council

Road and Drainage

Cross Sections: Landmark Road

and Shallow Road

SUBJECT TO APPROVAL

CRUSHED ROCK BACKFILL CRB INDICATES CRUSHED ROCK BACKFILL COMPACTED IN ACCORDANCE WITH MELTON CITY COUNCIL STANDARDS & SPECIFICATION CLASS 2 UNDER ROAD PAVEMENT & CLASS 3 BEHIND KERB

<u>LEGEND</u> — — — EXISTING SURFACE DESIGN SURFACE DRAINAGE PIPE/PIT — — — EXISTING DRAINAGE PIPE/PIT — — HYDRAULIC GRADE LINE CRUSHED ROCK BACKFILL

NOTES

PIPE TRENCHES WITHIN THE ROAD RESERVE MUST BE BACKFILLED WITH 20mm CLASS 3 CRUSHED ROCK TO BE COMPACTED TO A DRY DENSITY NOT LESS THAN 97% OF MAXIMUM FOUND IN THE STANDARD COMPACTION TEST FOR THE FOLLOWING:


- BENEATH THE ROAD PAVEMENT OR DRIVEWAY CROSSOVER TO THE UNDERSIDE OF THE PAVEMENT OR

- ADJACENT TO KERBING OR CONCRETE WORKS TO A LEVEL THAT IS NOT AFFECTED BY A 45 DEGREE ANGLE OF REPOSE FROM NEAR THE LOWER EDGE.

ALL DRAINAGE PIPES TO BE RUBBER RING BELLED SOCKET JOINT TYPE (RRJ).

ALL DRAINAGE PIPES SHALL BE CLASS 2 RCP, UNLESS OTHERWISE NOTED.

WHERE PITS DROP LESS THAN 50mm, THE PIT FLOOR MUST BE SHAPED TO MATCH THE LOWER HALF OF THE PIPE.

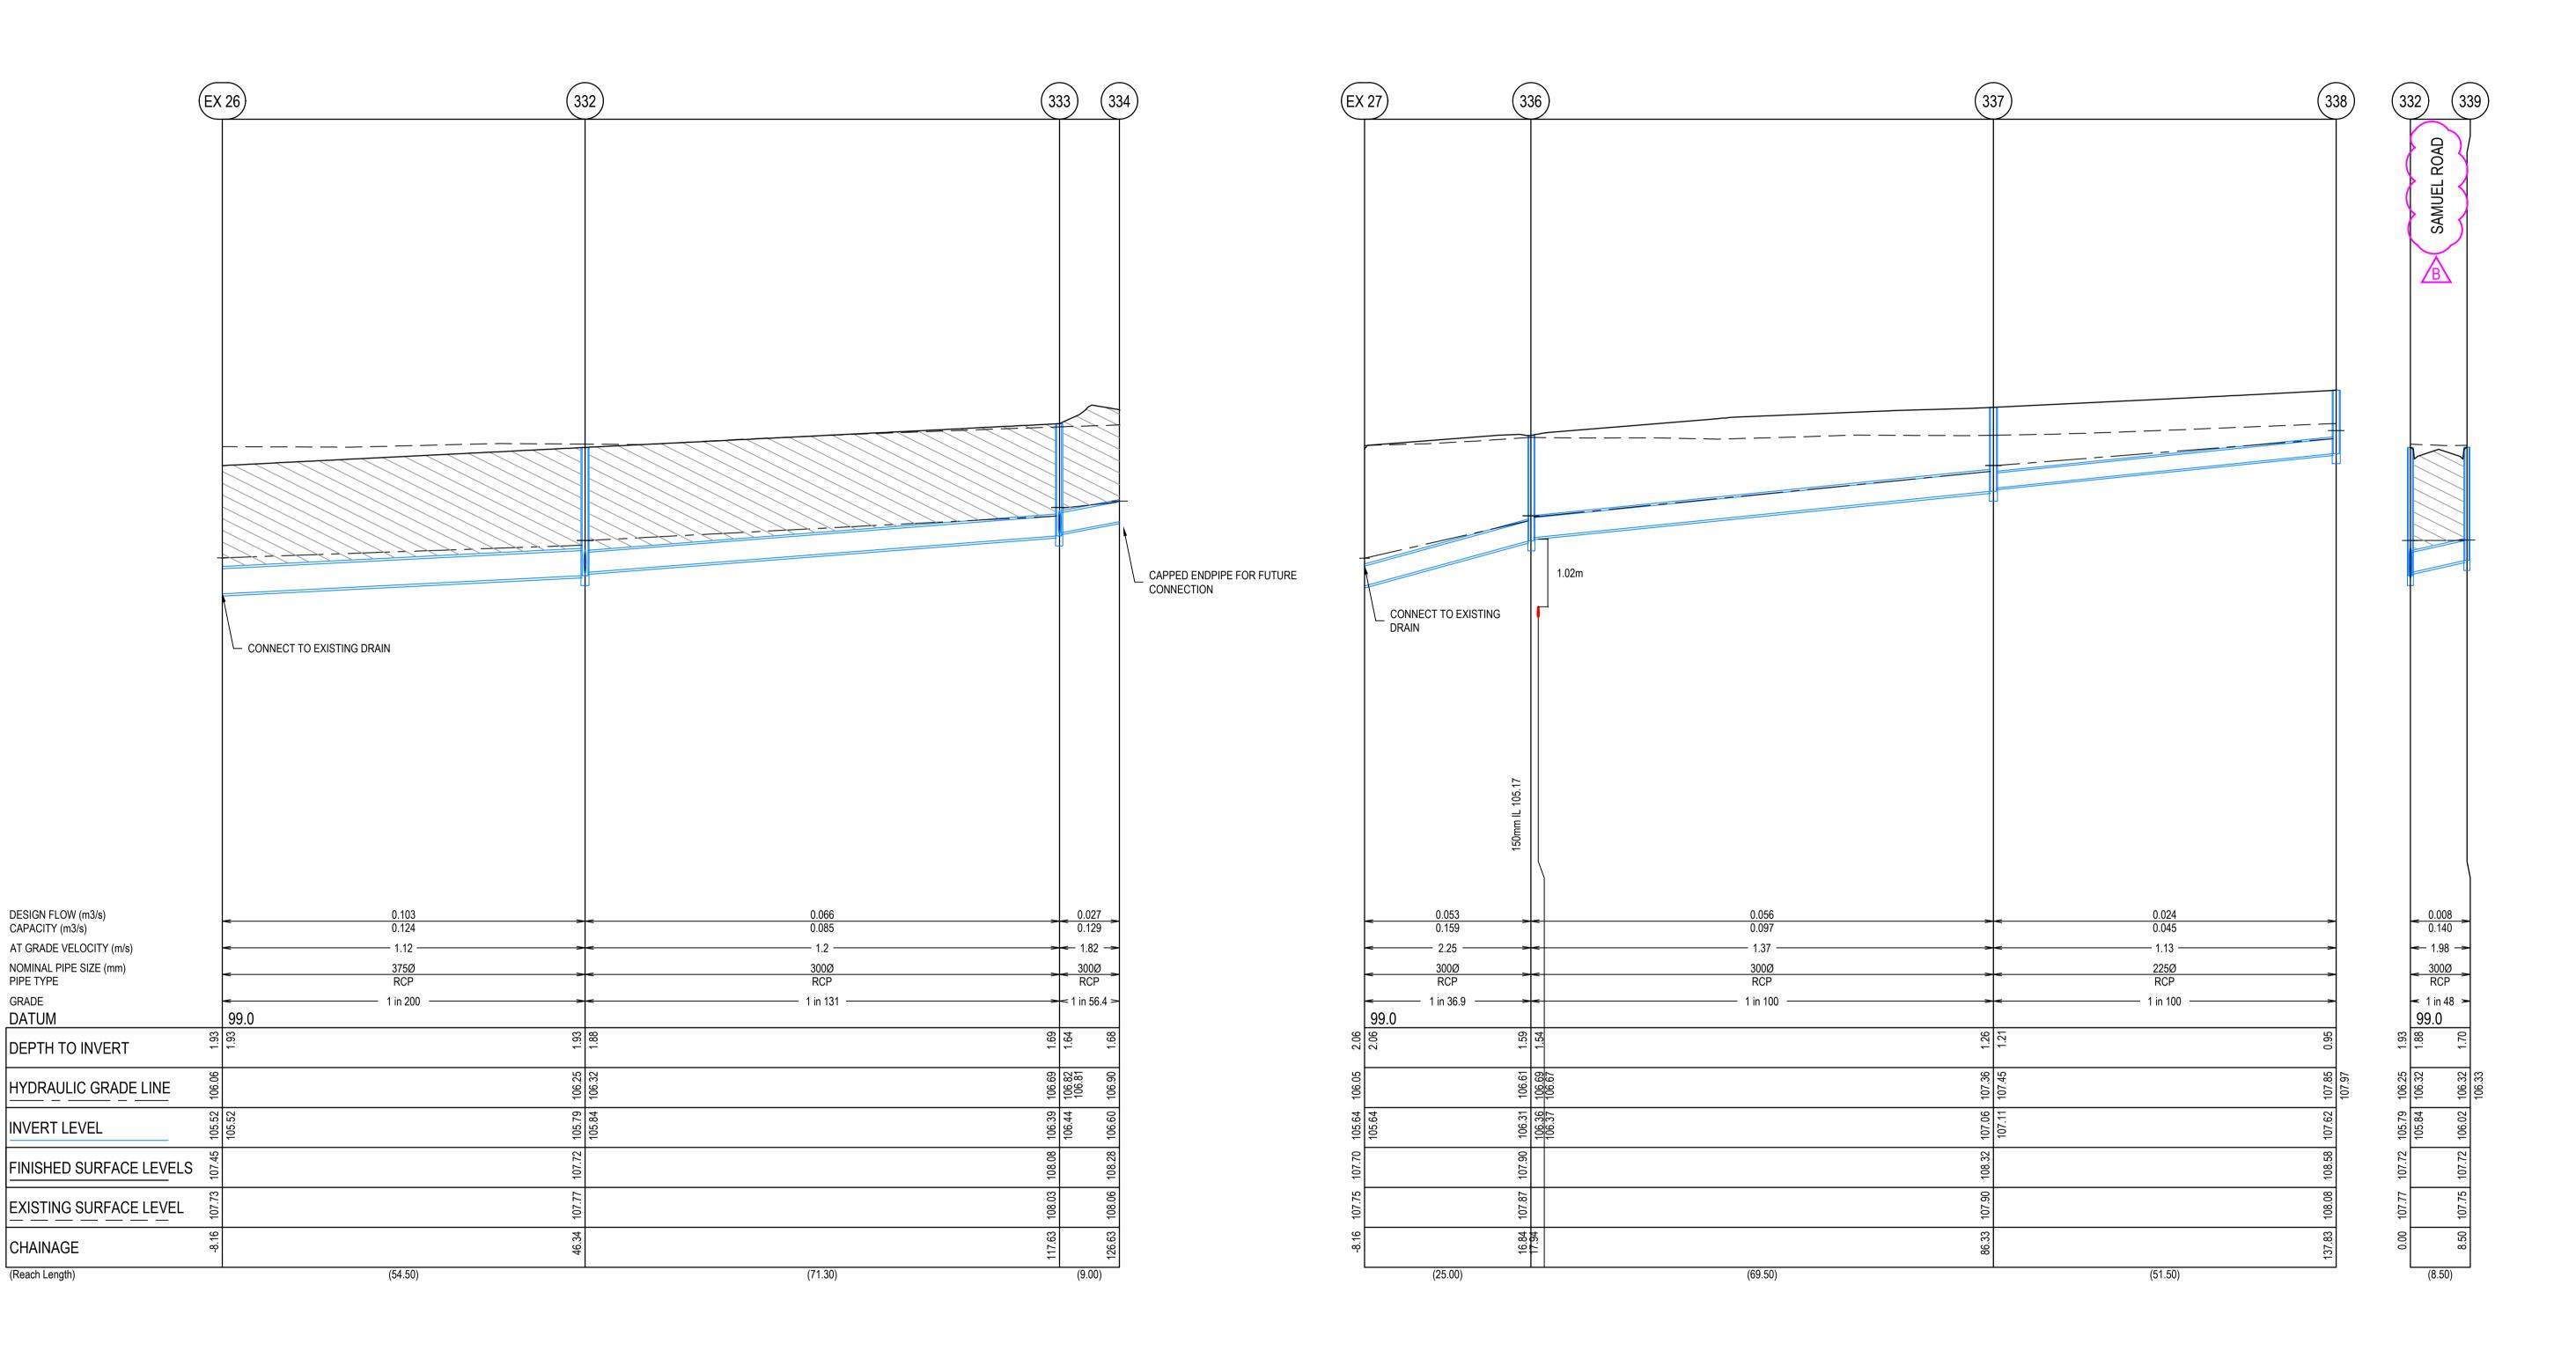


Al
T

standard drawings or as nominated on hard copy plans provided by SMEC. Any digital information supplied by this office is for information only. Any discrepancies should be discussed with the superintendent





All setting out should be carried out in accordance with MPA/Council's		TITLE	NAME	
standard drawings or as nominated on hard copy plans provided by SMEC. Any digital information supplied by this office is for information			DRAFTER	N.Green
only. Any discrepancies should be discussed with the superintendent.			DESIGNER	H.Ehsani
Management Too 9001	Management To Management Ad At Lental Management		CHECKED	L.Vieyra
Sualling Soot	S 480.	Son Ison	AUTHORISED	N.Hollow
		1400 ₇	REFERENCE No. 1	
Global-Mark.com.au®	Global-Mark.com.au®	Global-Mark.com.au [®]	REFERENCE No. 2	

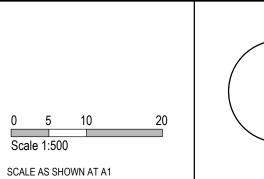



Seventh Bend - Stage 13

Melton City Council

Road and Drainage

Drainage Longitudinal Sections - 1

melways ref | PROJECT / DRAWING No. | 2250E-13-14 sheet no. Revision B

SUBJECT TO APPROVAL

CRUSHED ROCK BACKFILL CRB INDICATES CRUSHED ROCK BACKFILL COMPACTED IN ACCORDANCE WITH MELTON CITY COUNCIL STANDARDS & SPECIFICATION CLASS 2 UNDER ROAD PAVEMENT & CLASS 3 BEHIND KERB

<u>LEGEND</u> — — — EXISTING SURFACE DESIGN SURFACE DRAINAGE PIPE/PIT — — — EXISTING DRAINAGE PIPE/PIT — — HYDRAULIC GRADE LINE CRUSHED ROCK BACKFILL

PIPE TRENCHES WITHIN THE ROAD RESERVE MUST BE BACKFILLED WITH 20mm CLASS 3 CRUSHED ROCK TO BE COMPACTED TO A DRY DENSITY NOT LESS THAN 97% OF MAXIMUM FOUND IN THE STANDARD


COMPACTION TEST FOR THE FOLLOWING: - BENEATH THE ROAD PAVEMENT OR DRIVEWAY CROSSOVER TO THE UNDERSIDE OF THE PAVEMENT OR

- ADJACENT TO KERBING OR CONCRETE WORKS TO A LEVEL THAT IS NOT AFFECTED BY A 45 DEGREE ANGLE OF REPOSE FROM NEAR THE LOWER EDGE.

ALL DRAINAGE PIPES TO BE RUBBER RING BELLED SOCKET JOINT TYPE (RRJ).

ALL DRAINAGE PIPES SHALL BE CLASS 2 RCP, UNLESS OTHERWISE NOTED.

WHERE PITS DROP LESS THAN 50mm, THE PIT FLOOR MUST BE SHAPED TO MATCH THE LOWER HALF OF

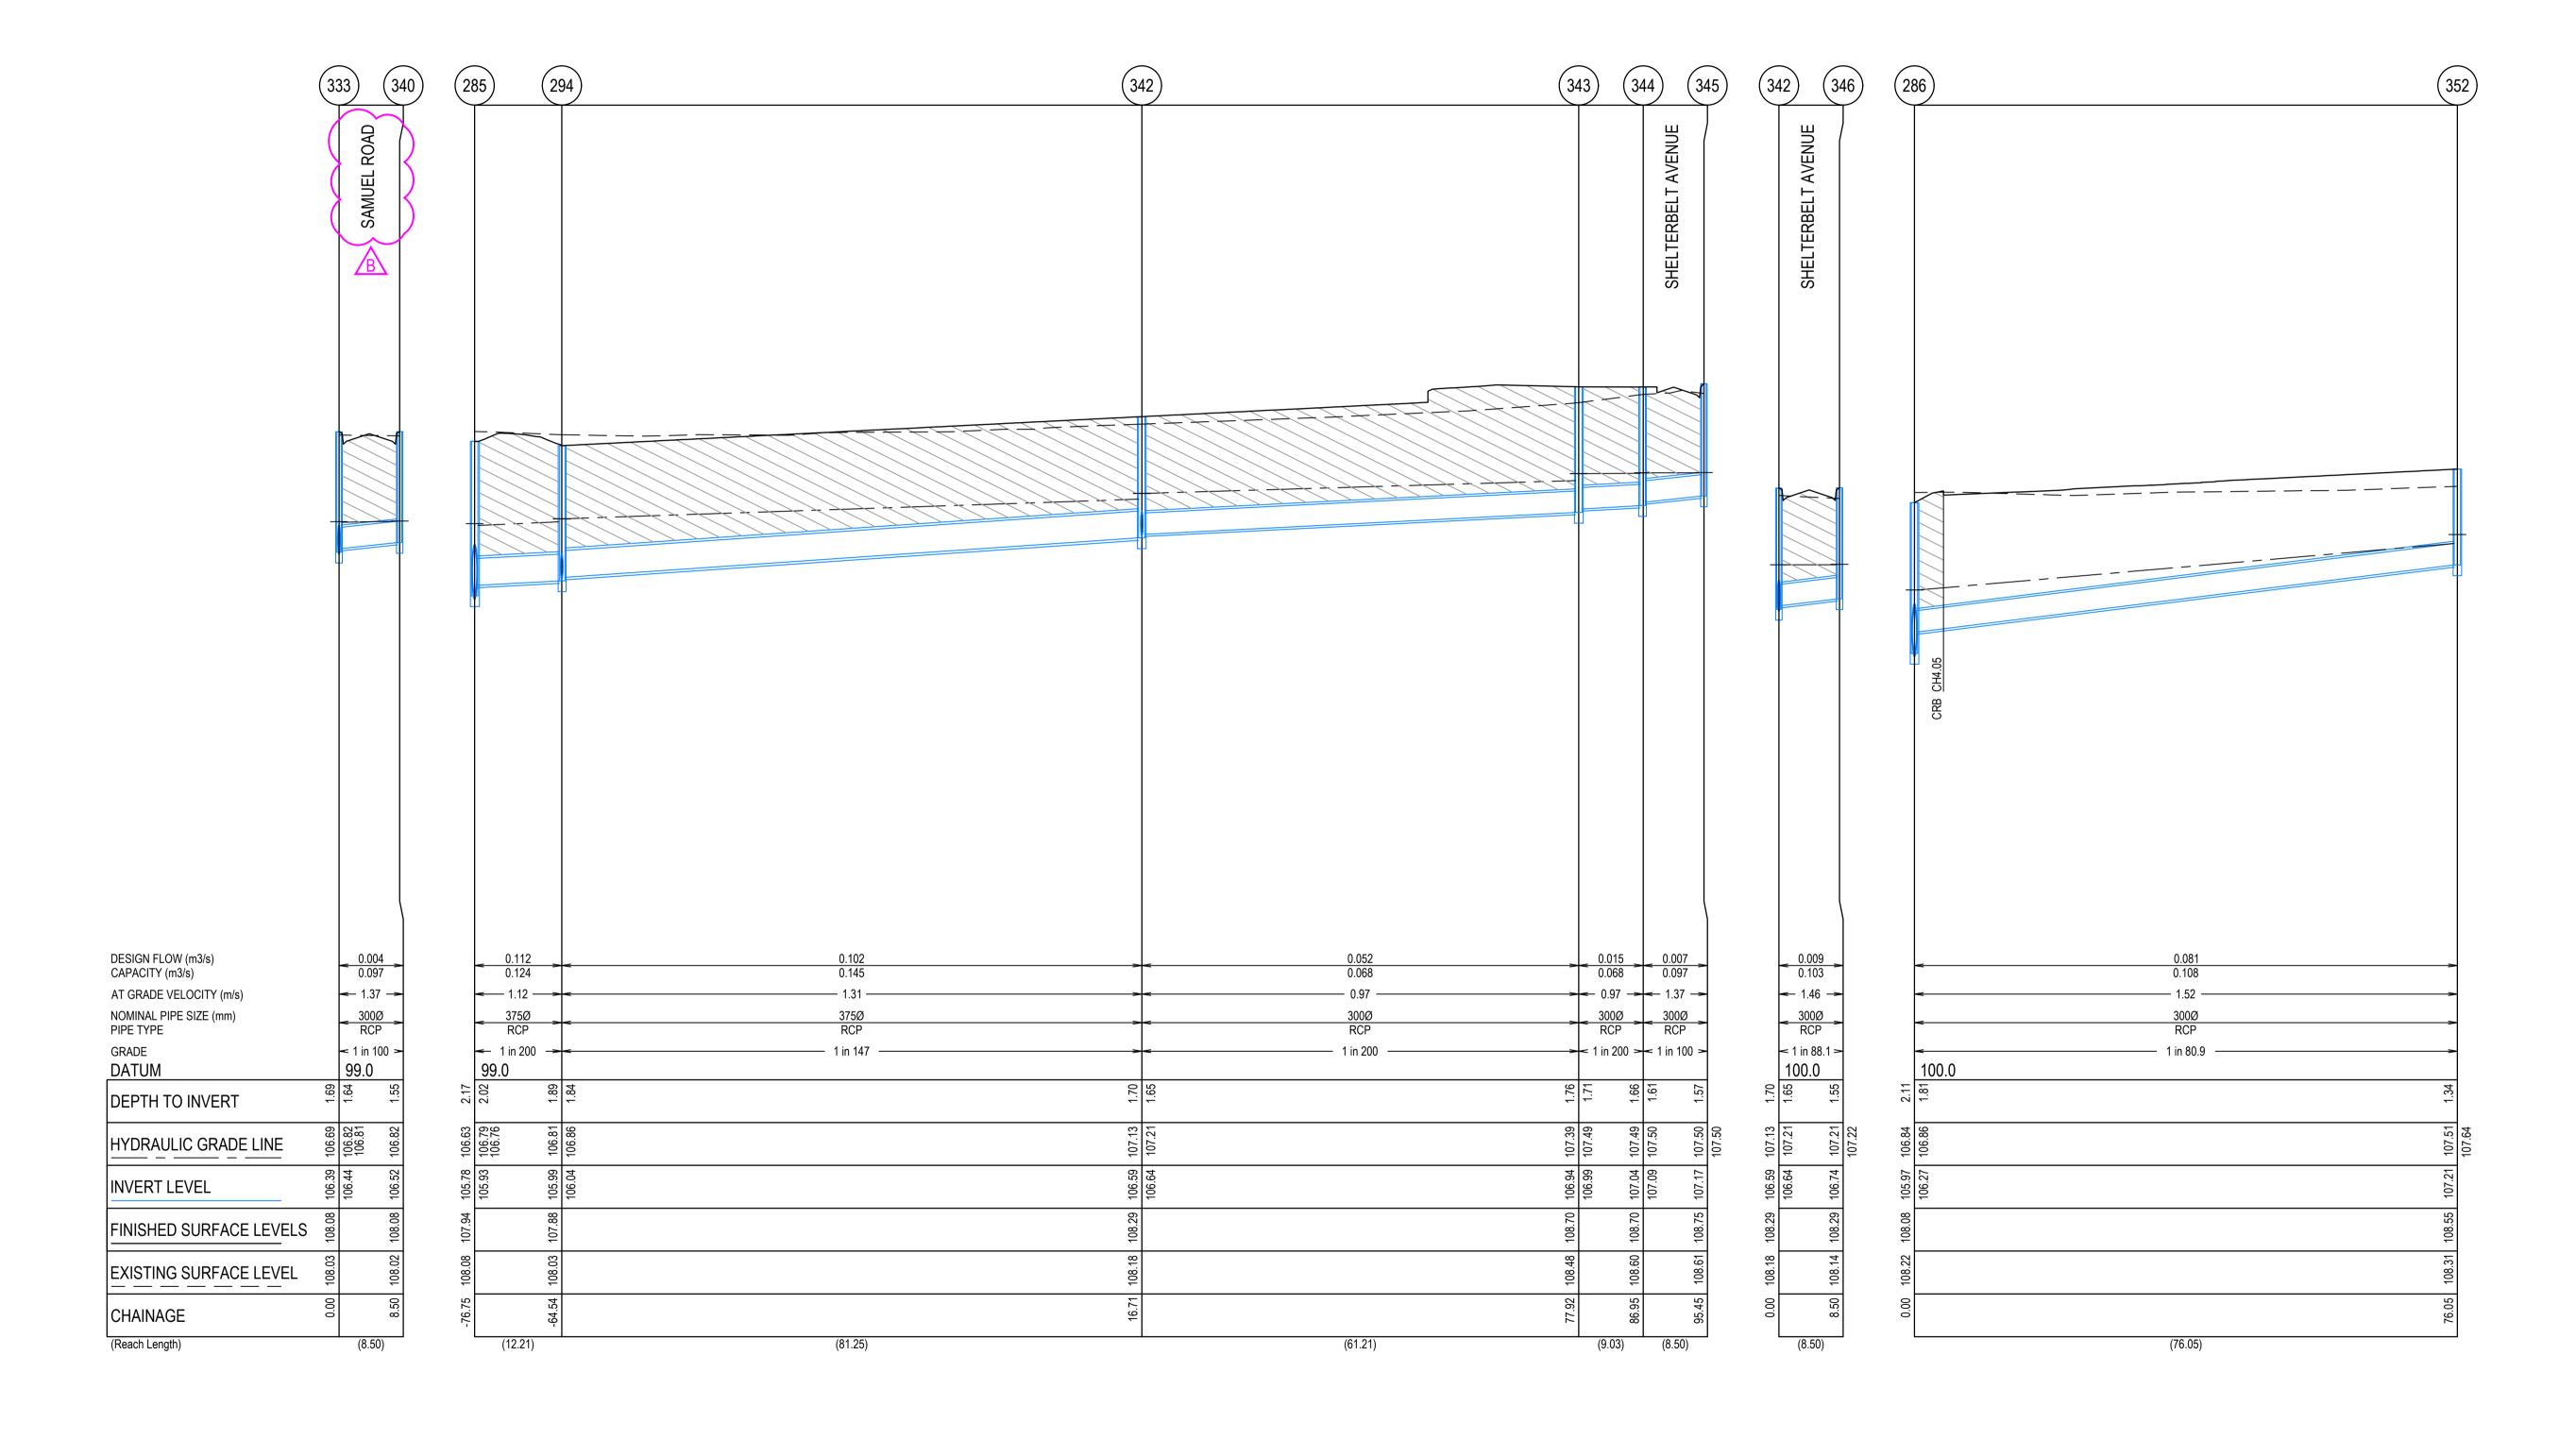

Seventh Bend - Stage 13

Melton City Council


Road and Drainage

Drainage Longitudinal Sections - 2 AMENDMENT / REVISION DESCRIPTION All setting out should be carried out in accordance with MPA/Council's NAME SMEC 03.04.20 ISSUED TO COUNCIL FOR APPROVAL standard drawings or as nominated on hard copy plans provided by N.Green SMEC. Any digital information supplied by this office is for information only. Any discrepancies should be discussed with the superintendent. DESIGNER H.Ehsani Member of the Surbana Jurong Group
© ABN 47 065 475 149 L.Vieyra AUTHORISED Tower 4, Level 20, 727 Collins Street SUBJECT TO APPROVAL MELWAYS REF | PROJECT / DRAWING No. | 2250E-13-15 REFERENCE No. 1 Docklands, VIC 3008 SHEET No. REVISION A Ph 03 9514 1500 SCALE AS SHOWN AT A1

CRUSHED ROCK BACKFILL
CRB INDICATES CRUSHED ROCK BACKFILL COMPACTED IN ACCORDANCE
WITH MELTON CITY COUNCIL STANDARDS & SPECIFICATION CLASS 2
UNDER ROAD PAVEMENT & CLASS 3 BEHIND KERB

NOTES

- 1. PIPE TRENCHES WITHIN THE ROAD RESERVE MUST BE BACKFILLED WITH 20mm CLASS 3 CRUSHED ROCK TO BE COMPACTED TO A DRY DENSITY NOT LESS THAN 97% OF MAXIMUM FOUND IN THE STANDARD COMPACTION TEST FOR THE FOLLOWING:
- BENEATH THE ROAD PAVEMENT OR DRIVEWAY CROSSOVER TO THE UNDERSIDE OF THE PAVEMENT OR CROSSOVER.
- ADJACENT TO KERBING OR CONCRETE WORKS TO A LEVEL THAT IS NOT AFFECTED BY A 45 DEGREE ANGLE OF REPOSE FROM NEAR THE LOWER EDGE.
- ALL DRAINAGE PIPES TO BE RUBBER RING BELLED SOCKET JOINT TYPE (RRJ).
- ALL DRAINAGE PIPES SHALL BE CLASS 2 RCP, UNLESS OTHERWISE NOTED.
- 4. WHERE PITS DROP LESS THAN 50mm, THE PIT FLOOR MUST BE SHAPED TO MATCH THE LOWER HALF OF THE PIPE.

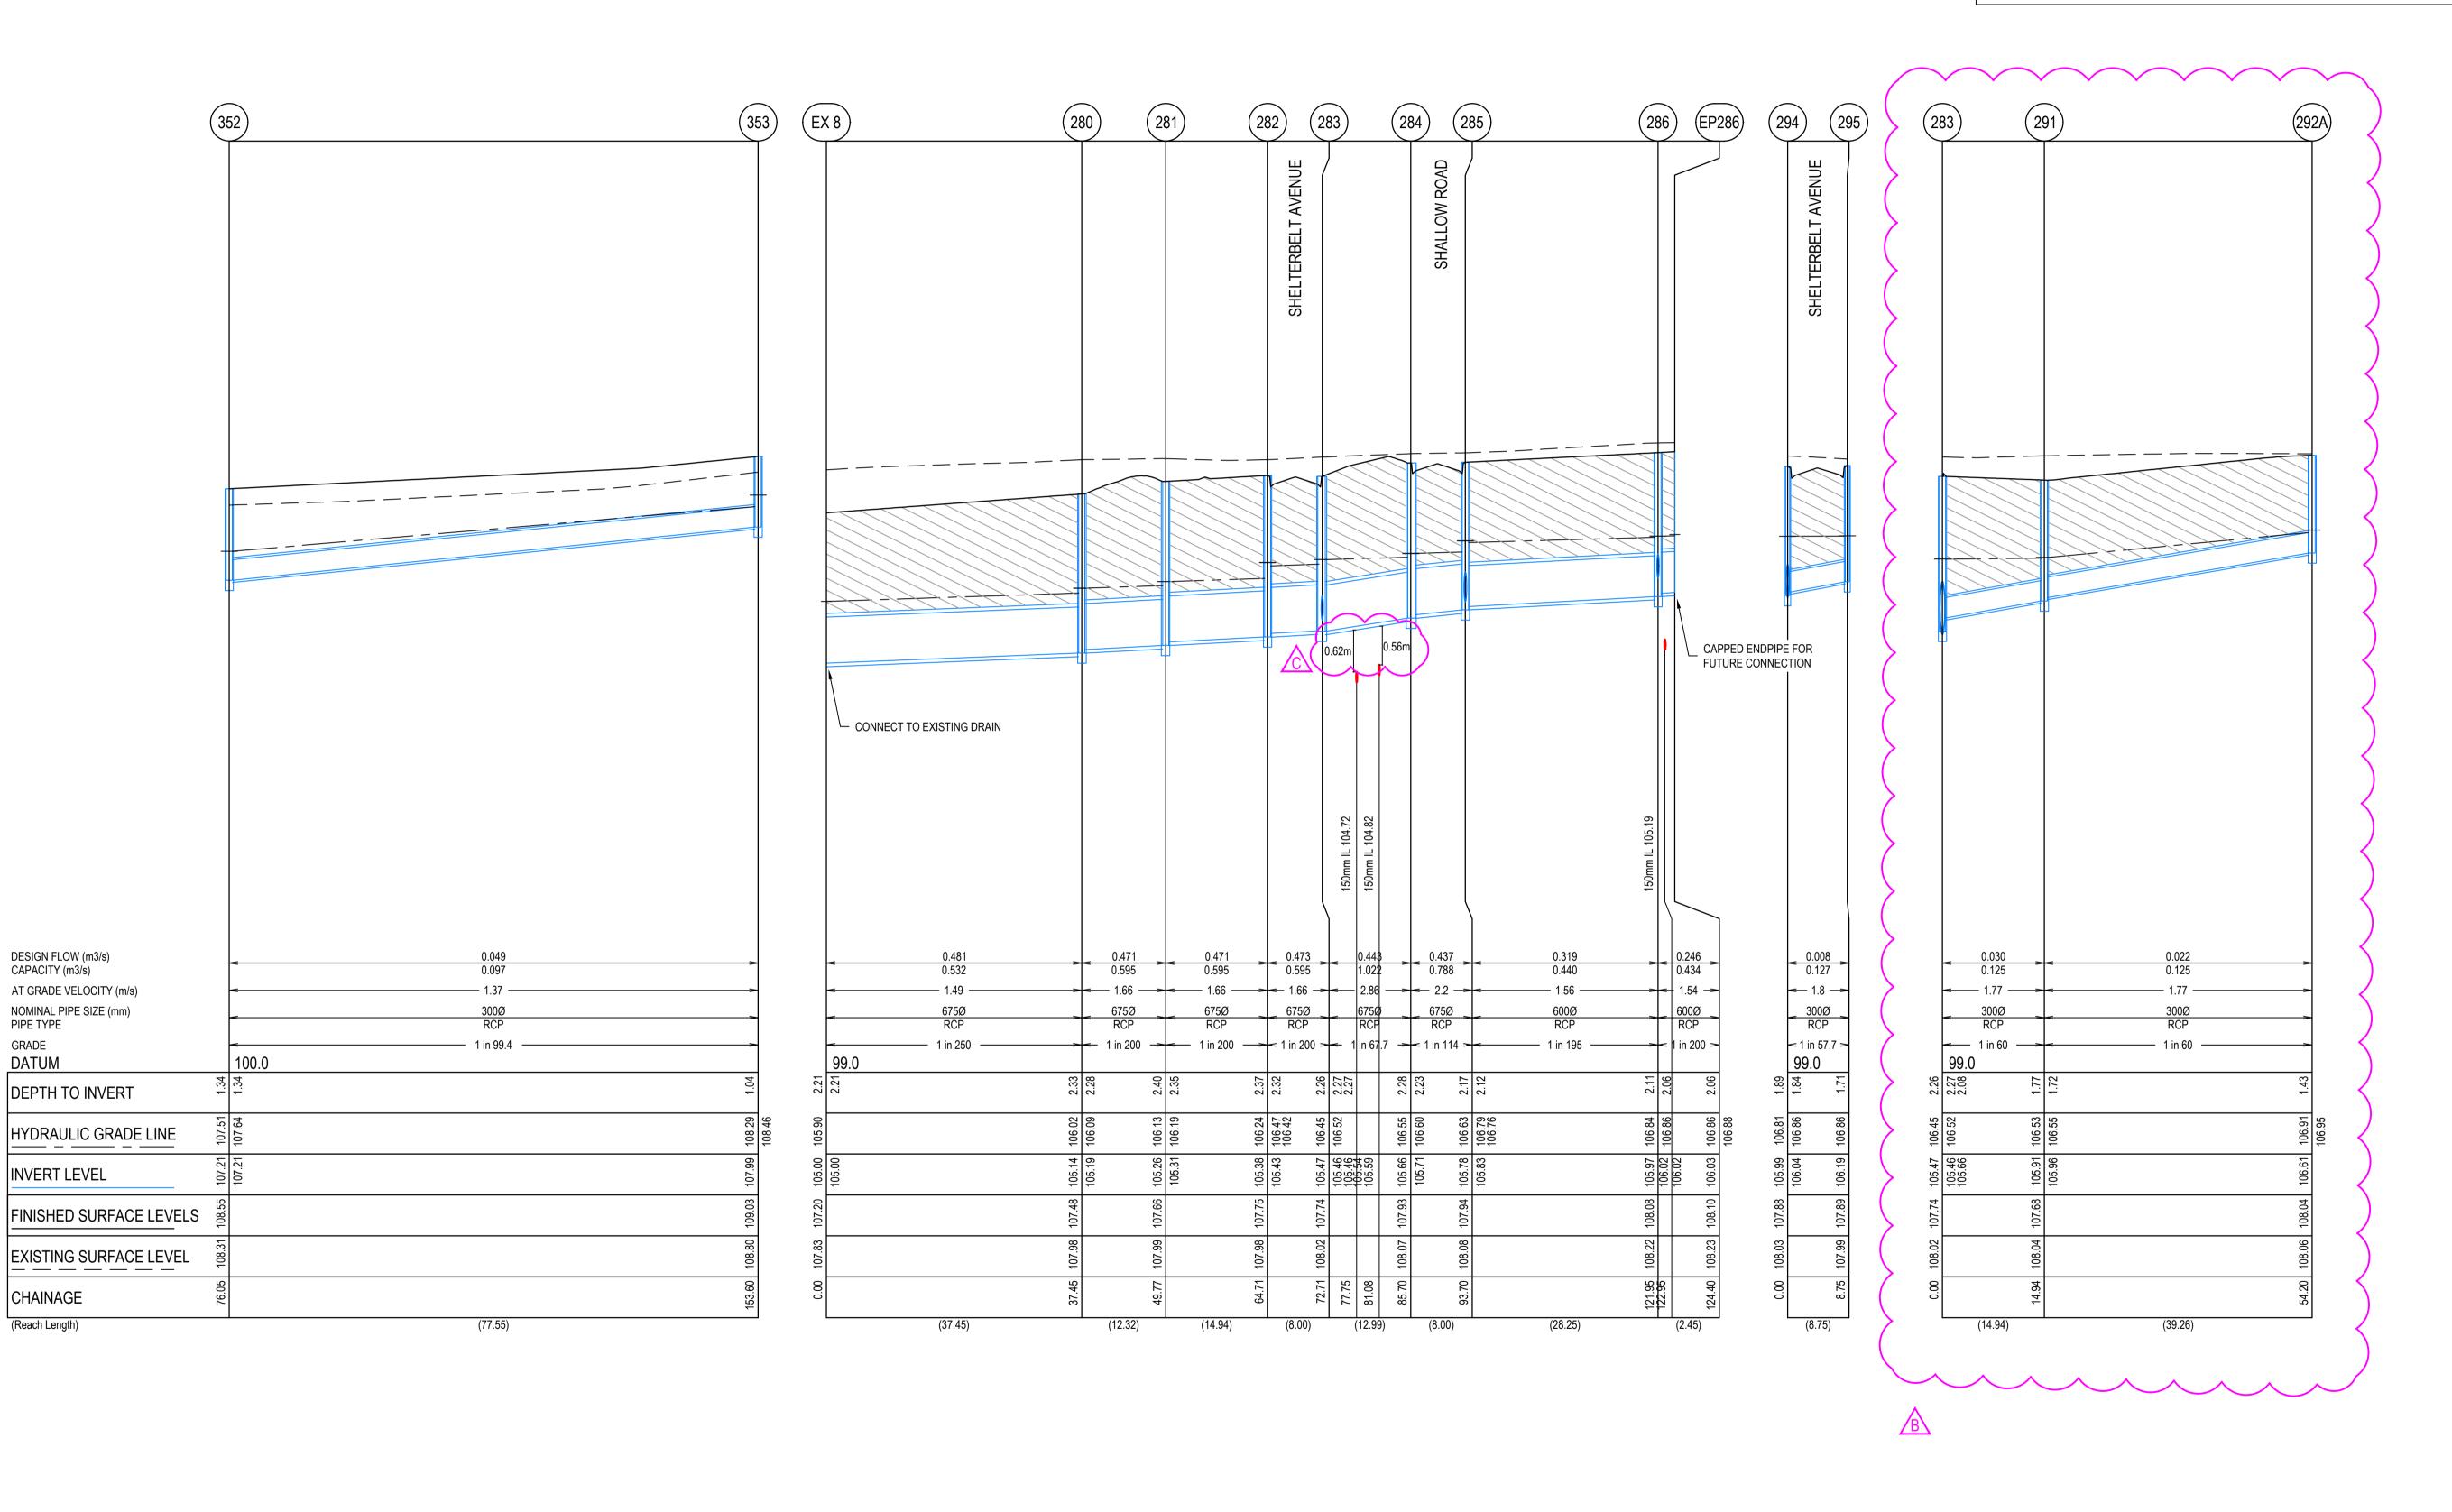

		SUBJECT TO APPROVAL	
С	20.08.20	SEWER CLEARANCE ADDED	AM
В	06.05.20	PIT REMOVED	AK
Α	03.04.20	ISSUED TO COUNCIL FOR APPROVAL	HE/NG
		,	520/51


DATE AMENDMENT / REVISION DESCRIPTION

JVAL	•	be carried out in accordan	
H	standard drawings of	or as nominated on hard co	py plans provided by
<i>,</i>	SMEC. Any digital inf	formation supplied by this o	office is for information
•	only. Any discrepand	ies should be discussed wi	th the superintender
V	# O Ph		
	Management	Sonagement. AGAL	atal Managemen
	1 0°	To The	Self.
	la)	\$7	Ĭ,

/ plans provided by ice is for information	DRAFTER	N.Green
the superintendent.	DESIGNER	H.Ehsani
anal Management	CHECKED	L.Vieyra
Management, 18014007	AUTHORISED	N.Hollow
4007	REFERENCE No. 1	
Global-Mark.com.au®	REFERENCE No. 2	

NAME

0 5 Scale 1:500	10	20	(
Scale 1.500			
SCALE AS SHOW	/N AT A1		

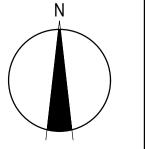

SMEC
Member of the Surbana Jurong Group
© ABN 47 065 475 149
Tower 4, Level 20, 727 Collins Street
Docklands, VIC 3008
Ph 03 9514 1500

Seventh Bend - Stage 13

Melton City Council

Road and Drainage

Drainage Longitudinal Sections - 3

 MELWAYS REF
 PROJECT / DRAWING No.
 SHEET No.
 REVISION

 342 K7
 2250E-13-16
 16 of 22
 C

CRUSHED ROCK BACKFILL

CRB INDICATES CRUSHED ROCK BACKFILL COMPACTED IN ACCORDANCE WITH MELTON CITY COUNCIL STANDARDS & SPECIFICATION CLASS 2 UNDER ROAD PAVEMENT & CLASS 3 BEHIND KERB

LEGEND

— — — EXISTING SURFACE

— DESIGN SURFACE

— DRAINAGE PIPE/PIT

— — — EXISTING DRAINAGE PIPE/PIT

HYDRAULIC GRADE LINE

CRUSHED ROCK BACKFILL

NOTES

1. PIPE TRENCHES WITHIN THE ROAD RESERVE MUST BE BACKFILLED WITH 20mm CLASS 3 CRUSHED ROCK TO BE COMPACTED TO A DRY DENSITY NOT LESS THAN 97% OF MAXIMUM FOUND IN THE STANDARD COMPACTION TEST FOR THE FOLLOWING:


- BENEATH THE ROAD PAVEMENT OR DRIVEWAY CROSSOVER TO THE UNDERSIDE OF THE PAVEMENT OR CROSSOVER.

CROSSOVER.
- ADJACENT TO KERBING OR CONCRETE WORKS TO A LEVEL THAT IS NOT AFFECTED BY A 45 DEGREE ANGLE OF REPOSE FROM NEAR THE LOWER EDGE.

ALL DRAINAGE PIPES TO BE RUBBER RING BELLED SOCKET JOINT TYPE (RRJ).

. ALL DRAINAGE PIPES TO BE ROBBER KING BELLED SOCKET JOINT TIPE (RKG

4. WHERE PITS DROP LESS THAN 50mm, THE PIT FLOOR MUST BE SHAPED TO MATCH THE LOWER HALF OF THE PIPE.

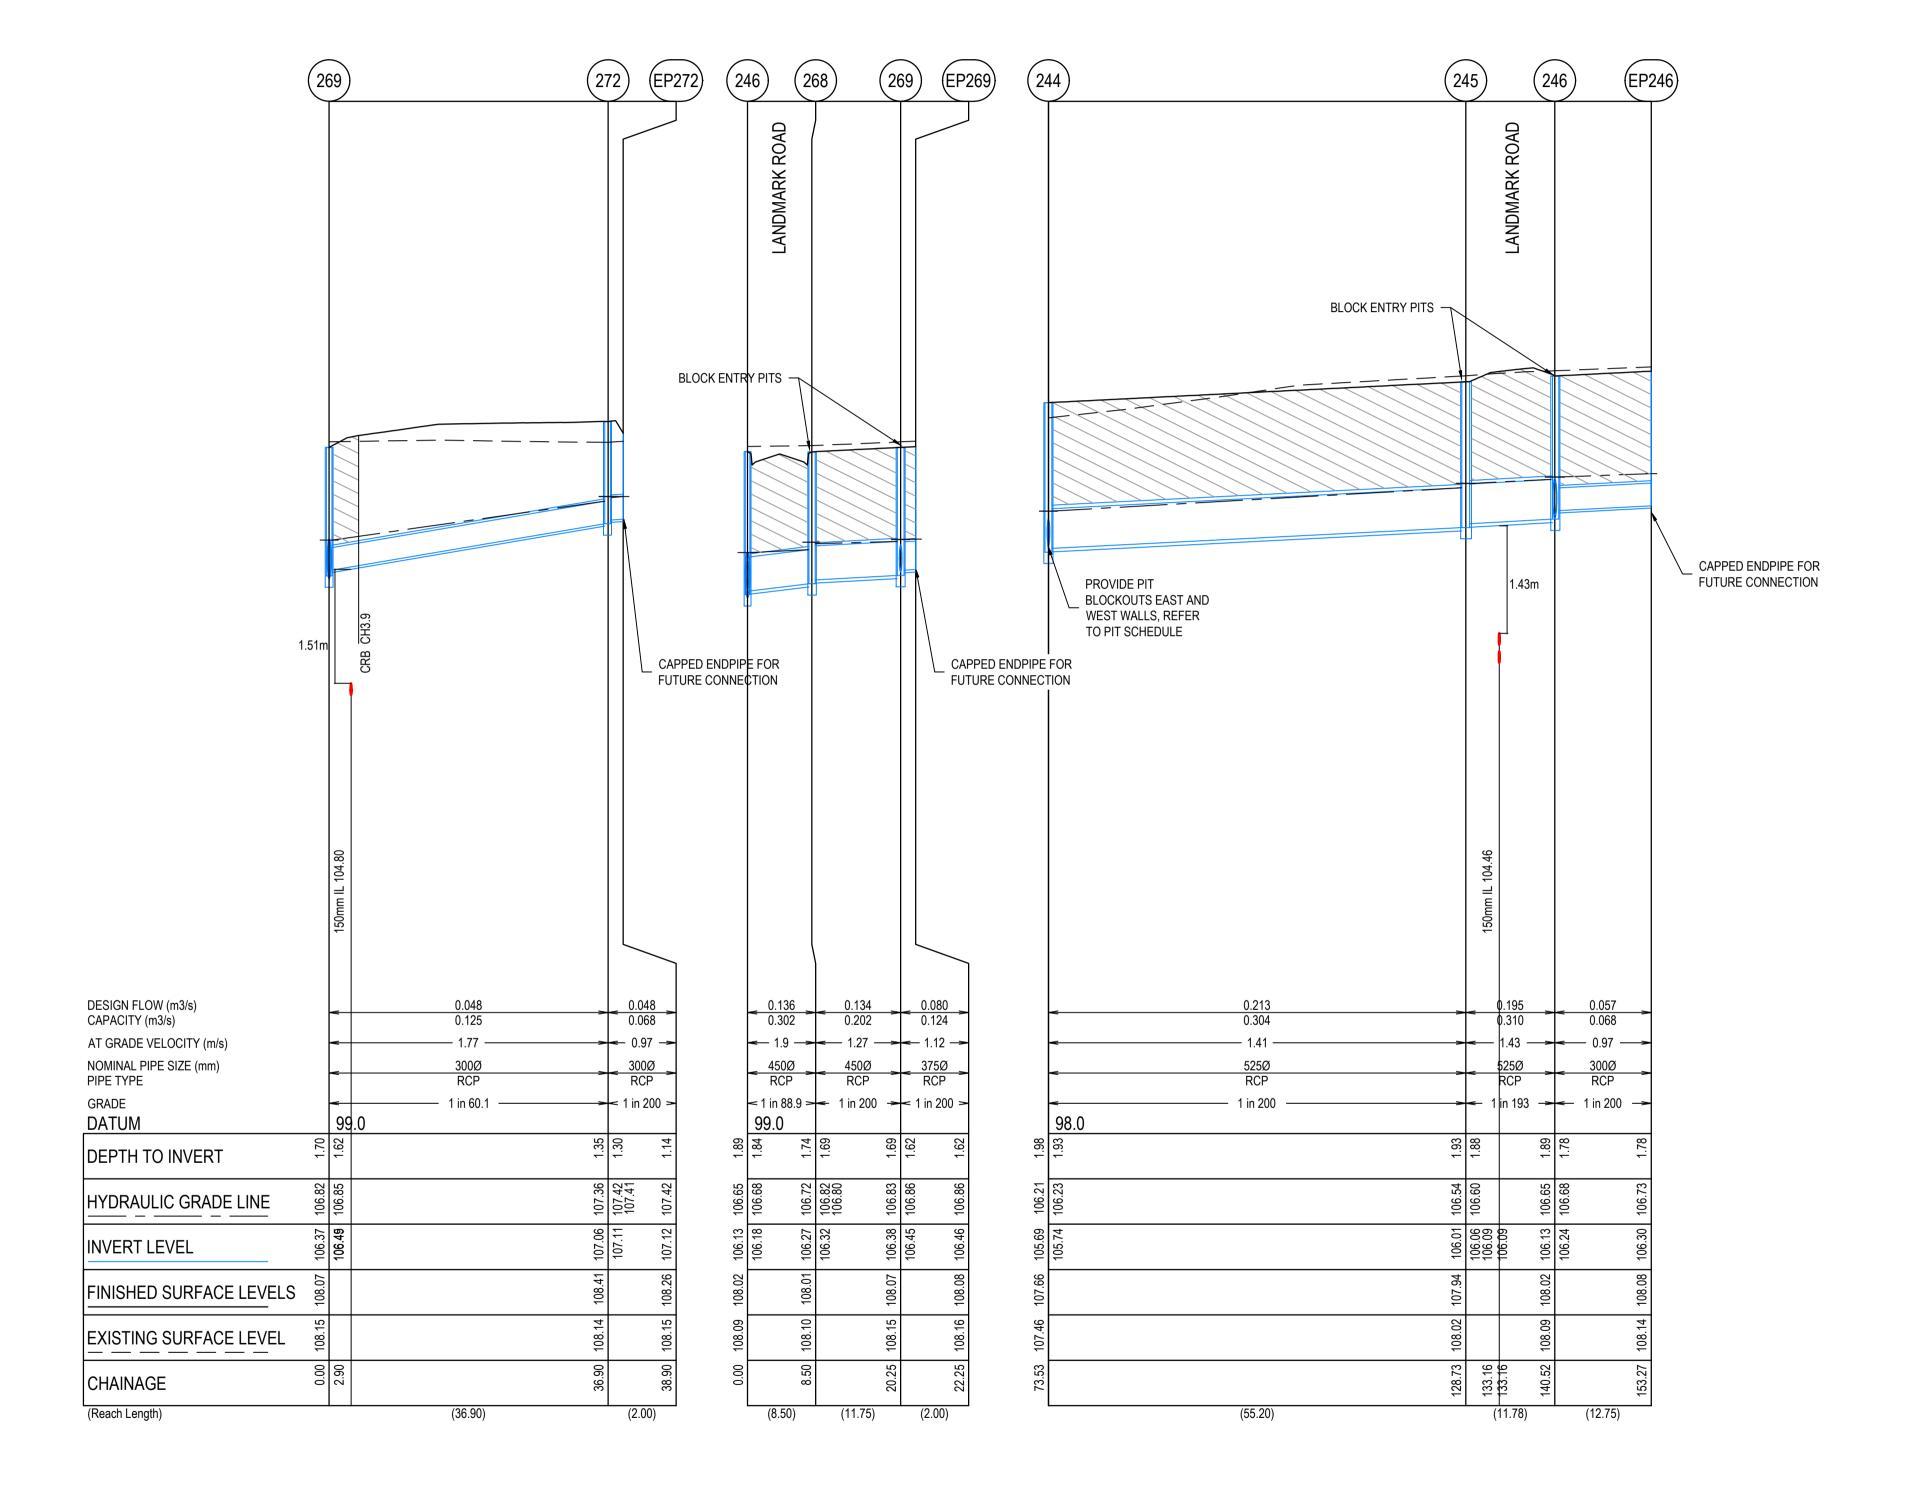

A 03.04.20 ISSUED TO COUNCIL FOR APPROVAL SEWER CLEARANCE ADDED AM LV

SUBJECT TO APPROVAL

All se stan SMECONILY.

All se stan SMECONILY.

AND LV


All se stan SMECONILY.

AND LV

AN

standard drawings o SMEC. Any digital inf	be carried out in accordant or as nominated on hard co formation supplied by this co ies should be discussed wi	py plans provided by office is for information
Management GO 9001	SHOW AS WAY A SOUTH A	Management is of

0 5 10
Scale 1:500
SCALE AS SHOWN AT A1
_

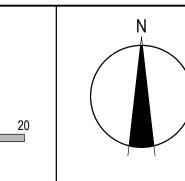

SMEC
Member of the Surbana Jurong Group
© ABN 47 065 475 149
Tower 4, Level 20, 727 Collins Street
Docklands, VIC 3008
Ph 03 9514 1500

Seventh Bend - Stage 13

Melton City Council

Road and Drainage

Drainage Longitudinal Sections - 4

SHEET No. REVISION B


MELWAYS REF PROJECT / DRAWING No. 2250E-13-17


	PIT	INTERNAL INLET			NLET	PIT SCHEDULE OUTLET PIT						
NAME	TYPE	WD	LEN	DIA	INV LEV	DIA	INV LEV	SETOUT RL	DEPTH	STD DWG	REMARKS	
EX 26	ENDPIPE			375	105.52	375	105.52	107.446	1.926		CONNECT TO EXISTING ENDPIPE	
332	SINGLE SIDE ENTRY PIT GRATED	600	900	300	105.843	375	105.793	107.719	1.926	EDCM 601		
				300	105.843	0.0						
333	SINGLE SIDE ENTRY PIT GRATED	600	900	300	106.438	300	106.388	108.075	1.687	EDCM 601		
333	SINGLE SIDE ENTRY PIT GRATED	000	900			300	100.300	100.075	1.007	EDCW 60 I		
				300	106.438							
334	ENDPIPE	600	900	300	106.598	300	106.598	108.281	1.683		CAPPED ENDPIPE FOR FUTURE CONNECTION	
EX 27	ENDPIPE			300	105.637	300	105.637	0	2.059		CONNECT TO EXISTING ENDPIPE	
336	JUNCTION PIT	600	900	300	106.365	300	106.315	107.9	1.586	EDCM 605		
337	JUNCTION PIT	600	900	225	107.11	300	107.06	108.322	1.263	EDCM 605		
338	JUNCTION PIT	600	900			225	107.625	108.579	0.954	EDCM 605		
339	SINGLE SIDE ENTRY PIT GRATED	600	900			300	106.02	107.722	1.702	EDCM 601		
340	SINGLE SIDE ENTRY PIT GRATED	600	900			300	106.523	108.078	1.555	EDCM 601		
				275	405.000						LIALINGLIED TO COO. COO	
285	SINGLE SIDE ENTRY PIT GRATED	900	900	375	105.926	675	105.776	107.941	2.165	EDCM 601 & 607	HAUNCHED TO 600x900	
				600	105.826							
294	SINGLE SIDE ENTRY PIT GRATED	600	900	375	106.037	375	105.987	107.881	1.894	EDCM 602		
				300	106.037							
342	SINGLE SIDE ENTRY PIT GRATED	600	900	300	106.639	375	106.589	108.287	1.698	EDCM 601		
				300	106.639		123.000					
343	JUNCTION PIT	750	900	300	106.995	300	106.945	108.705	1.76	EDCM 605		
344	SINGLE SIDE ENTRY PIT GRATED	750	900	300	107.09	300	107.04	108.703	1.664	EDCM 601		
345	SINGLÉ SIDE ENTRY PIT GRATED	600	900			300	107.175	108.748	1.573	EDCM 601		
346	SINGLE SIDE ENTRY PIT GRATED	600	900			300	106.735	108.29	1.555	EDCM 601		
286	SINGLE SIDE ENTRY PIT GRATED	900	900	300	106.271	600	105.971	108.082	2.111	EDCM 601 & 607	HAUNCHED TO 600x900	
				600	106.021							
352	SINGLE SIDE ENTRY PIT GRATED	600	900	300	107.211	300	107.211	108.553	1.342	EDCM 605		
353	SINGLE SIDE ENTRY PIT GRATED	600	900			300	107.991	109.029	1.038	EDCM 605		
EX 8	ENDPIPE	000	300	675	104.995	675	104.995	107.2	2.205	LDOW 000	CONNECT TO EXISTING ENDPIPE	
		1400	000							EDOM 004 0 007		
280	SĬNGLE ŠIDE ENTRY PIŤ GRATĚD	1400	900	675	105.194	675	105.145	107.476	2.332	EDCM 601 & 607	HAUNCHED TO 600x900	
281	DOUBLE SIDE ENTRY PIT GRATED	1400	900	675	105.306	675	105.256	107.66	2.404	EDCM 602 & 607 / E	HAUNCHED TO 600x900	
282	SINGLE SIDE ENTRY PIT GRATED	900	1050	675	105.431	675	105.381	107.748	2.368	EDCM 601 & VICROADS SD1023	HAUNCHED TO 600x900	
283	SINGLE SIDE ENTRY PIT GRATED	1400	1050	675	105.464	675	105.471	107.736	2.272	EDCM 601 & VICROADS SD1023	HAUNCHED TO 600x900	
200	CINGLE GIBE ENTRY I'M GRATED	1700	1000	070		070	100.471	107.700	2.212	EBOW 601 & VIONOABO 6B1020	7DX TIMONOTIES TO COCKSOO	
				300	105.658				,			
284	SINGLE SIDE ENTRY PIT GRATED	1400	1050	675	105.706	675	105.656	107.932	2.276	EDCM 601 & VICROADS SD1023	HAUNCHED TO 600x900	
204	SINGLE SIDE ENTRY FIT GRATED	1400	1030	073	103.700	073	103.030	107.932		EDCIVIOUT & VICKOADS 3D 1023	HAUNCHED 10 000x300	
EP286	ENDPIPE			600	106.034	600	106.033	108.096	2.063		CAPPED ENDPIPE FOR FUTURE CONNECTION	
295	SINGLE SIDE ENTRY PIT GRATED	600	900			300	106.189	107.894	1.705	EDCM 601		
291	DOUBLE SIDE ENTRY PIT GRATED	600	900	300	105.957	300	105.907	107.68	1.772	EDCM 602		
292a	JUNCTION PIT	600	900		100.007	300	106.557	108.042	1.485	EDCM 605		
292a 269		750	900	300	106.449	450	106.374	108.074			ENTRY PIT TO BE BLOCKED	
209	SINGLE SIDE ENTRY PIT GRATED	750	900			450	100.374	100.074	1.7	EDCM 601	ENIKT PIL TO BE BLOCKED	
				375	106.449	_						
272	JUNCTION PIT	600	900	300	107.113	300	107.063	108.414	1.351	EDCM 605		
EP272	ENDPIPE	_		300	107.123	300	107.123	108.261	1.138		CAPPED ENDPIPE FOR FUTURE CONNECTION	
246	DOUBLE SIDE ENTRY PIT GRATED	600	1200	450	106.175	525	106.125	108.018	1.893	EDCM 602 & 607	HAUNCHED TO 600X900. ENTRY PIT TO BE BLOCKED	
				300	106.238							
268	DOUBLE SIDE ENTRY PIT GRATED	750	900	450	106.315	450	106.265	108.015	1.75	EDCM 602	ENTRY PIT TO BE BLOCKED	
EP269	ENDPIPE	7.00	1	375	106.463	300	106.463	108.084	1.621	LBOW 602	CAPPED ENDPIPE FOR FUTURE CONNECTION	
LF209	LINDFIFE			3/3	100.403	300	100.403	100.004	1.021			
			<i> </i>								HAUNCHED TO 600X900 - TO BE CONVERTED TO GEP IN FUT STAGE	
244	JUNCTION PIT	900	900	525	105.738	525	105.688	107.665	1.977	EDCM 601 & 607	51AGE 525Ø BLOCKOUT EAST WALL IL 107.665	
			ノノ								300Ø BLOCKOUT EAST WALL IL 107.665	
		◇◇ ◇		200	105.0						JUUW DLUCKUUT SUUTH WALL IL 105.8	
0.45	OINOLE CIDE ENERGY DIE COLOR	000	4000	300	105.8		100.011	107.011	4.60-	EDOMONA O VICTORIO	HALINOUED TO COOME THE TO THE TOTAL THE THE TOTAL THE THE TOTAL THE TOTAL THE TOTAL THE TOTAL THE THE TOTAL THE THE THE TOTAL THE THE THE TOTAL THE THE THE THE TOTAL THE THE THE THE THE THE TOTAL THE	
245	SINGLE SIDE ENTRY PIT GRATED	900	1200	525	106.064	525	106.014	107.941	1.927	EDCM 601 & VICROADS SD1023	HAUNCHED TO 600X900. ENTRY PIT TO BE BLOCKED	
		✓		255	400.00		100.00:	100.000			0.0000	
EP246	ENDPIPE			300	106.301	300	106.301	108.082	1.78		CAPPED ENDPIPE FOR FUTURE CONNECTION	
						300		107.669	1.556	EDCM 601		
267	SINGLE SIDE ENTRY PIT GRATED	600	900				106.113					


REV	DATE	AMENDMENT / REVISION DESCRIPTION
Α	03.04.20	ISSUED TO COUNCIL FOR APPROVAL
В	06.05.20	PIT REMOVED
С	20.08.20	PITS RE-SIZED
D	14.09.20	UPDATED REFERENCE TO STANDARD DRAWINGS
Е	01.10.20	UPDATED REFERENCE TO STANDARD DRAWINGS
_		

standard drawings or as nominated on hard copy plans provided by SMEC. Any digital information supplied by this office is for information only. Any discrepancies should be discussed with the superintendent.

All setting out should be carried out in accordance with MPA/Council's N.Green DESIGNER H.Ehsani L.Vieyra AUTHORISED REFERENCE No. 1

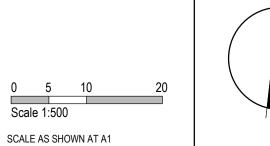

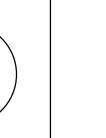

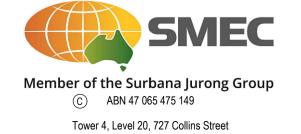

Docklands, VIC 3008 Ph 03 9514 1500

Seventh Bend - Stage 13

Melton City Council

Road and Drainage

Pit Schedule

PIPE TRENCHES WITHIN THE ROAD RESERVE MUST BE BACKFILLED WITH 20mm CLASS 3 CRUSHED ROCK TO BE COMPACTED TO A DRY DENSITY NOT LESS THAN 97% OF MAXIMUM FOUND IN THE STANDARD

- BENEATH THE ROAD PAVEMENT OR DRIVEWAY CROSSOVER TO THE UNDERSIDE OF THE PAVEMENT OR

- ADJACENT TO KERBING OR CONCRETE WORKS TO A LEVEL THAT IS NOT AFFECTED BY A 45 DEGREE

WHERE PITS DROP LESS THAN 50mm, THE PIT FLOOR MUST BE SHAPED TO MATCH THE LOWER HALF OF

ALL DRAINAGE PIPES TO BE RUBBER RING BELLED SOCKET JOINT TYPE (RRJ). ALL DRAINAGE PIPES SHALL BE CLASS 2 RCP, UNLESS OTHERWISE NOTED.

COMPACTION TEST FOR THE FOLLOWING:

ANGLE OF REPOSE FROM NEAR THE LOWER EDGE.

CROSSOVER.

THE PIPE.

MELWAYS REF PROJECT / DRAWING No. 2250E-13-18

SHEET No. REVISION E

DWG PATH: V:_Vault\Projects_Urban\2250E-Exford Road, Melton\2250E-13\Dwgs\2250E-13-18.dwg PRINTED BY: AM13398 on 01/10/2020 at 04:05:29 PM


SUBJECT TO APPROVAL


AK


AM


AM AM


LV

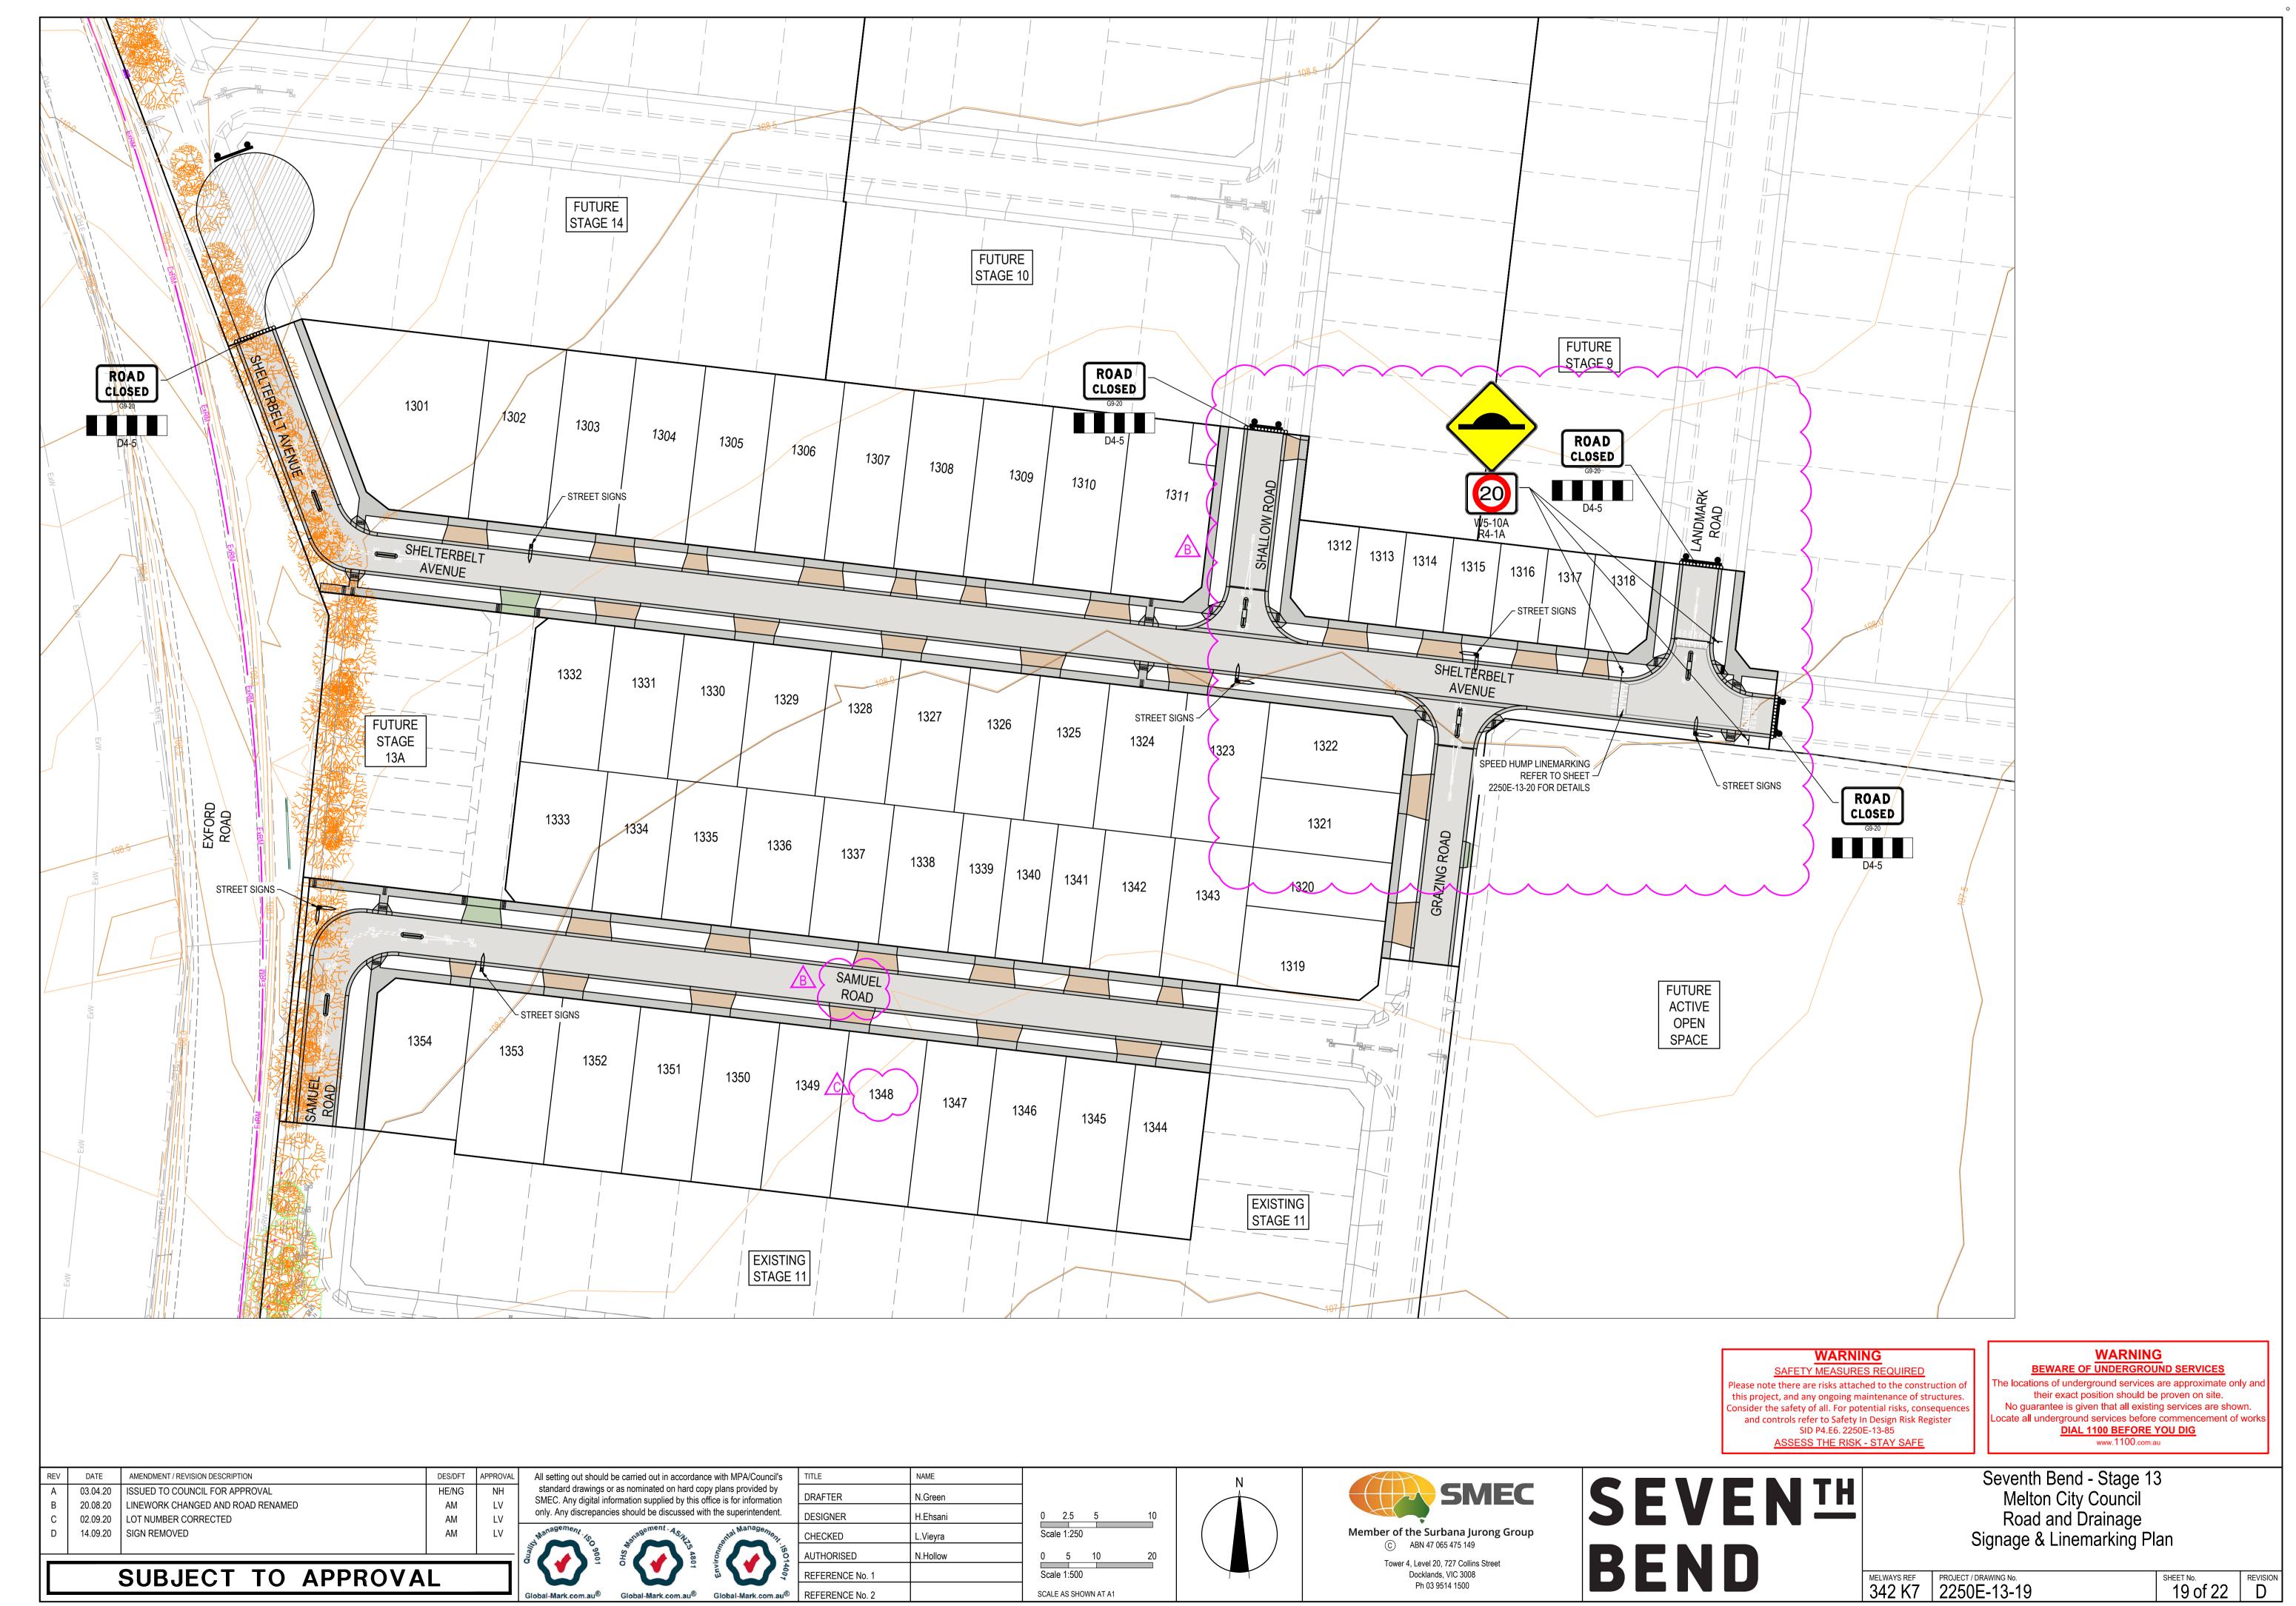


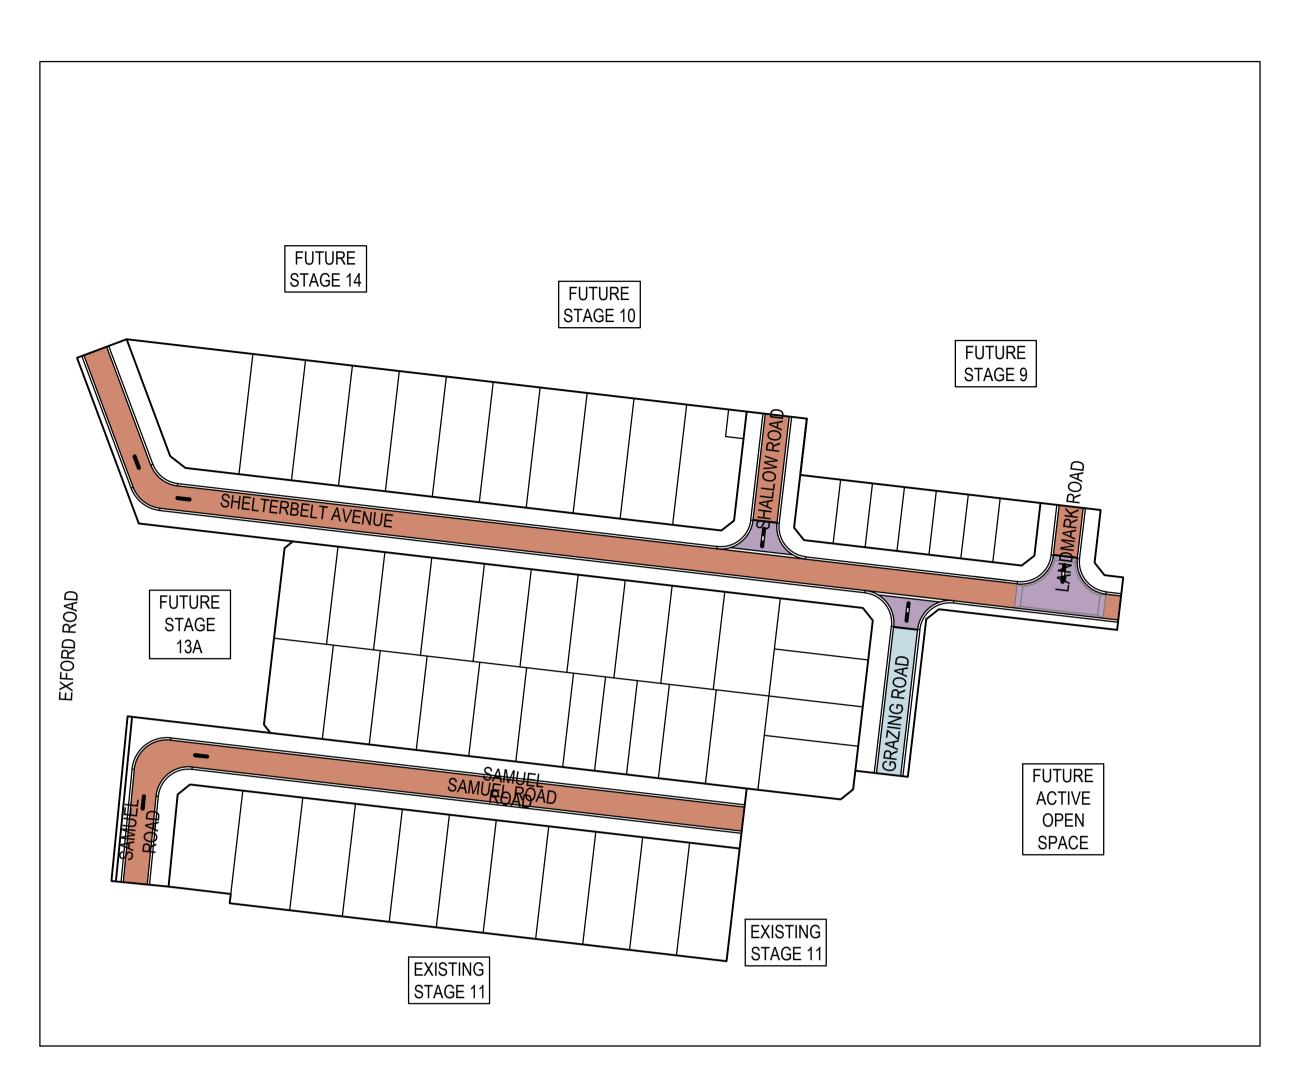

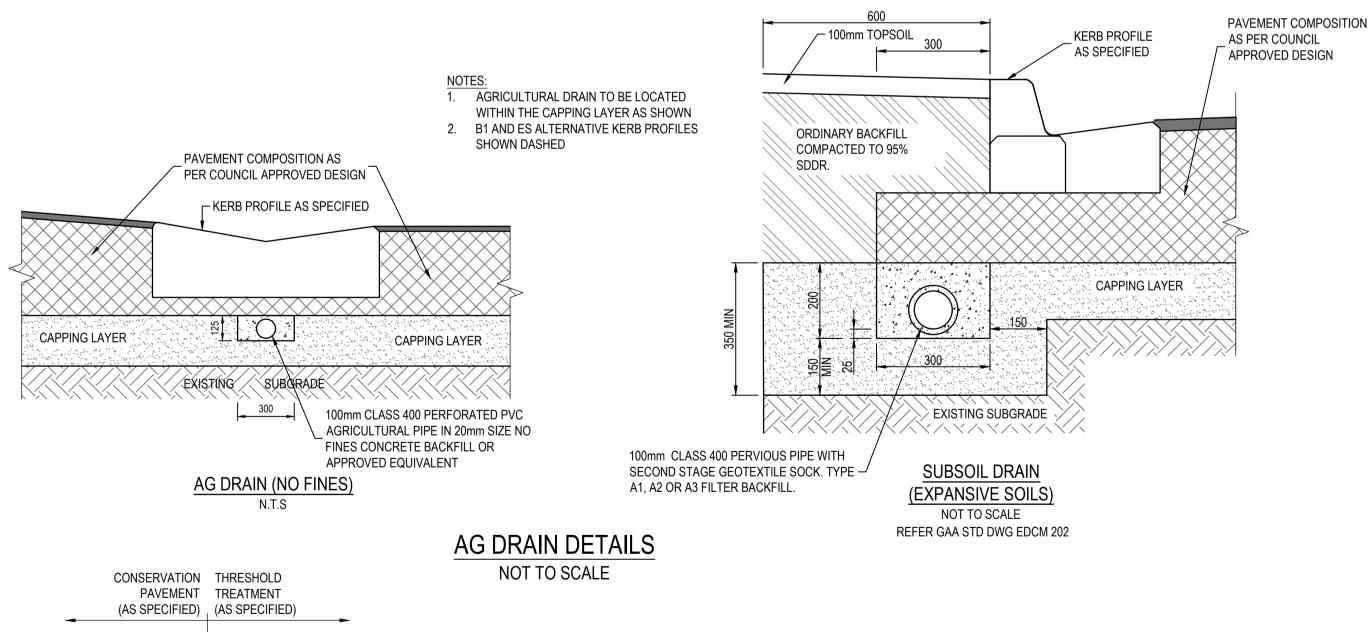

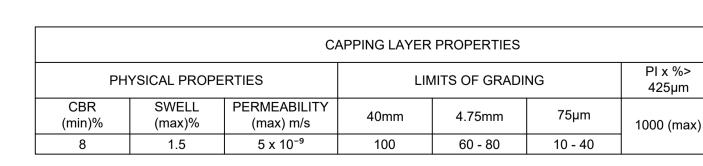

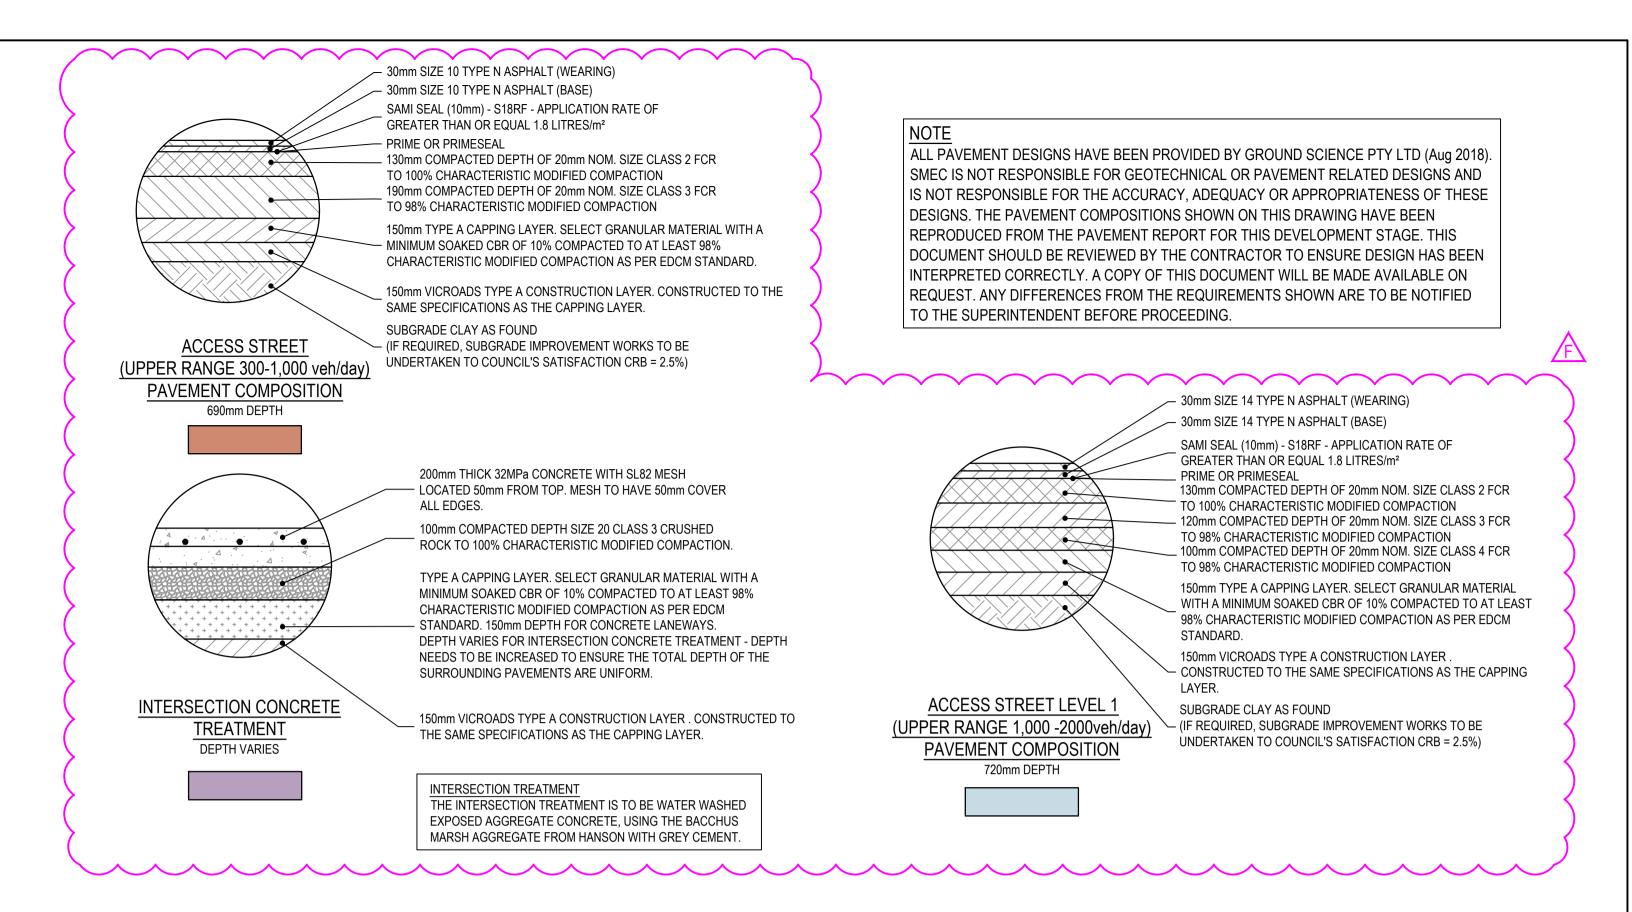

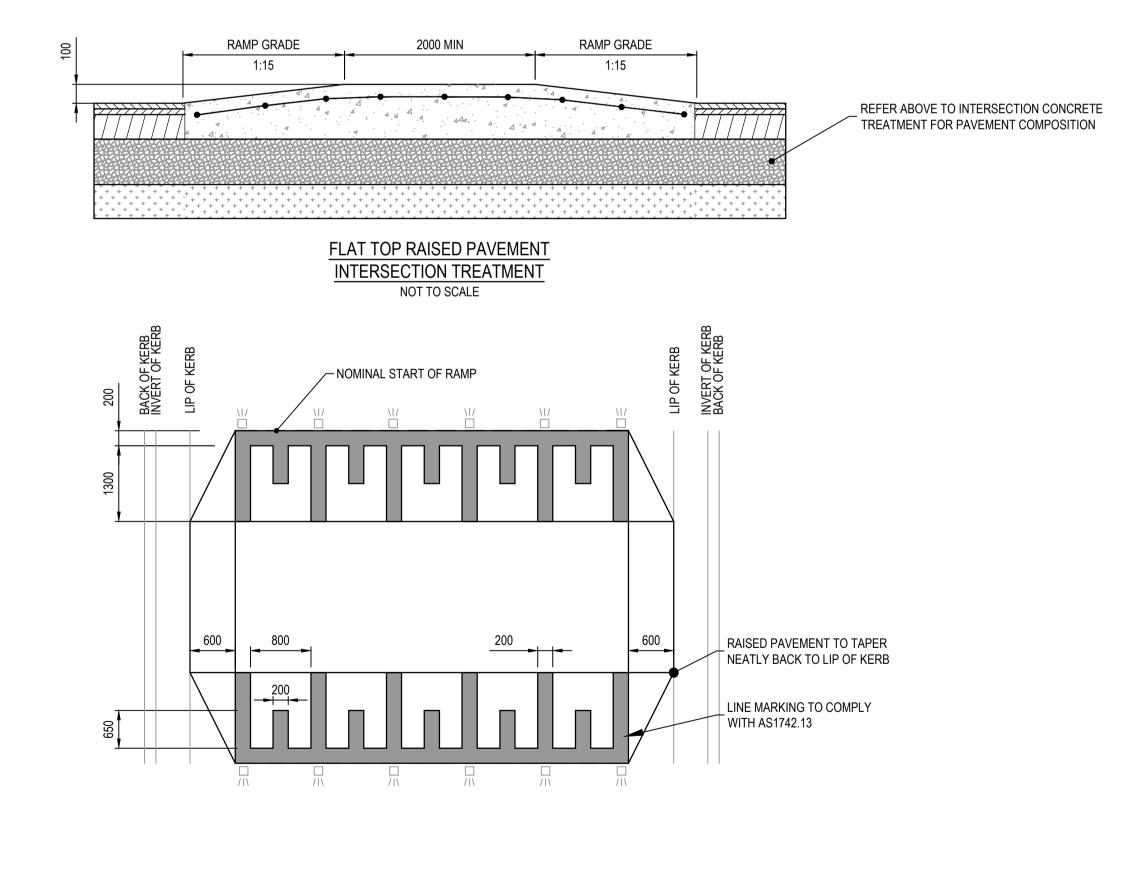

LINE MARKING FOR RAISED PAVEMENTS NOT TO SCALE

SUBJECT TO APPROVAL									
F	08.10.20	PAVEMENT COMPOSITION DETAIL UPDATED	AK	LV					
Ε	01.10.20	PAVEMENT COMPOSITION UPDATED	AM	LV					
D	30.09.20	PAVEMENT COMPOSITION UPDATED	AM	LV					
С	14.09.20	PAVEMENT COMPOSITION UPDATED	AM	LV					
Α	03.04.20	ISSUED TO COUNCIL FOR APPROVAL	HE/NG	NH					
REV	DATE	AMENDMENT / REVISION DESCRIPTION	DES/DFT	APPROVAL					

STRIP

ASPHALT ──►

SUBGRADE -

JOINT DETAIL FOR ROAD PAVEMENT & INTERSECTION THRESHOLD TREATMENT NOT TO SCALE


BASE COURSE ----

SUBBASE COURSE ---

CAPPING LAYER ——

All setting out should be carried out in accordance with MPA/Council's standard drawings or as nominated on hard copy plans provided by SMEC. Any digital information supplied by this office is for information only. Any discrepancies should be discussed with the superintendent.

DRAFTER N.Green DESIGNER H.Ehsani _.Vieyra AUTHORISED N.Hollow REFERENCE No. 1

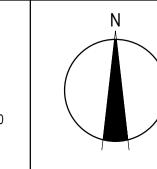

PLASTICITY

INDEX

25 (max)

SCALE AS SHOWN AT A1



Docklands, VIC 3008

Ph 03 9514 1500


SEVENTH BEND Tower 4, Level 20, 727 Collins Street

Seventh Bend - Stage 13 Melton City Council Road and Drainage **Pavement Details**

342 K7 PROJECT / DRAWING No. 2250E-13-20 SHEET No. REVISION F

JOINT DETAIL NOTES:

- SAW JOINTS ARE TO BE PLACED AT A MAXIMUM 5m SPACING AT
- INTERSECTIONS AND CONSTRUCTED 18-24 HOURS AFTER POURING. TRANSVERSE/CONTRACTION JOINTS ARE TO BE PLACED AT A MAXIMUM SPACING OF 12m.
- ISOLATION JOINTS ARE TO BE PLACED AROUND PITS.
- ALL JOINTS SHALL BE LOCATED AND SPACED IN ACCORDANCE WITH "CEMENT AND CONCRETE ASSOCIATION OF AUSTRALIA - CONCRETE PAVEMENT DESIGN FOR RESIDENTIAL STREETS 1997".

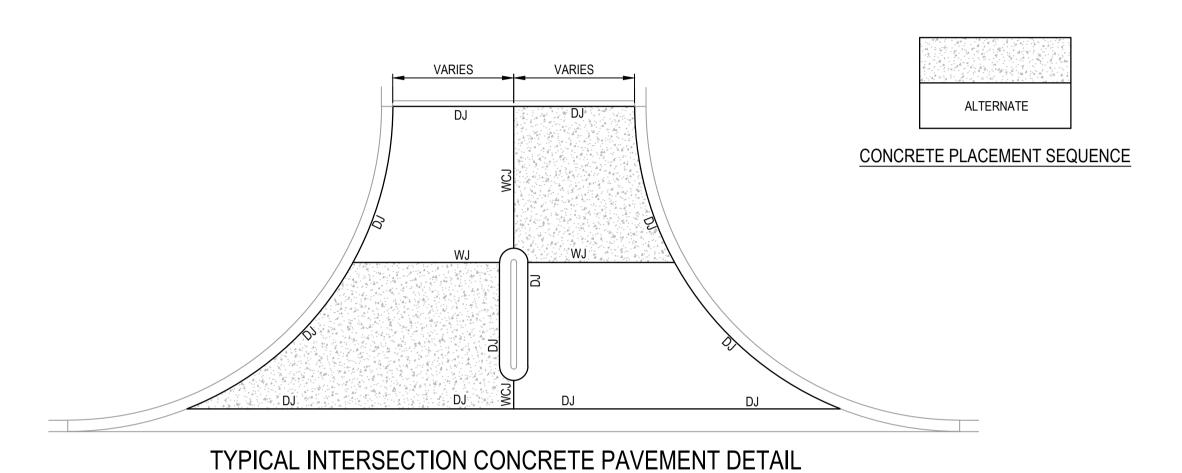

CONCRETE NOTES:

GENERAL

- ENGINEERING DRAWINGS MUST NOT BE SCALED
- CONTRACTORS TO VERIFY ALL DIMENSIONS ON SITE PRIOR TO COMMENCEMENT OF ANY WORKS
- ANY DISCREPANCIES MUST BE REFERRED TO THE ENGINEER IMMEDIATELY TO ENSURE CORRECT RECTIFICATION BEFORE PROCEEDING WITH THE WORK.
- ALL MATERIALS AND WORKMANSHIP SHALL COMPLY WITH APPROPRIATE SAA CODES, VICTORIAN BUILDING REGULATIONS, AND BUILDING CODE OF AUSTRALIA
- ALL REFERENCES TO SAA CODES, VBR'S AND BCA SHALL INCLUDE ALL AMENDMENTS 1.6. SUBSTITUTION SHALL NOT BE PERMITTED WITHOUT THE APPROVAL OF THE ENGINEER

CONCRETE

- 2.1. ALL CONCRETE SHALL BE IN ACCORDANCE WITH AS3600. CONCRETE COMPRESSION STRENGTH SHALL BE: 32MPA AT 28 DAYS FOR PAVEMENT OR AS NOTED ON DRAWINGS
- WHEELBARROW RUNS IF USED MUST BE SUPPORTED DIRECTLY FROM THE FORMWORK AND NOT FROM THE REINFORCEMENT
- MECHANICALLY VIBRATE CONCRETE DURING THE CONCRETE POUR 2.3.
- CONCRETE SURFACES MUST BE ADEQUATELY CURED. CONCRETE SHALL BE CURED IN ACCORDANCE WITH AS3600 AND NOT TO BE TRAFFICKED UNTIL AT LEAST SEVEN DAYS AFTER POURING.
- CONCRETE SIZES AS DRAWN ARE MINIMUM AND DO NOT INCLUDE APPLIED FINISHES
- UNSPECIFIED CONSTRUCTION JOINTS MUST NOT BE MADE WITHOUT THE ENGINEERS PRIOR WRITTEN APPROVAL

REINFORCEMENT

- 3.1. REINFORCEMENT IS REPRESENTED DIAGRAMMATICALLY AND NOT NECESSARILY IN TRUE PROJECTION. CLEAR COVER NOTED ON DRAWING(S) IS IN ACCORDANCE WITH AS3600 AND SHOULD NOT BE VARIED
- 3.2. LAPS IN REINFORCEMENT SHOULD COMPLY WITH AS3600
- FIELD WELDING OF REINFORCEMENT IS ONLY PERMITTED WITH THE ENGINEER'S WRITTEN APPROVAL. 3.3.
- ALL REINFORCEMENT IS TO BE ACCURATELY PLACED, TIED AND SUPPORTED IN POSITION BY BAR CHAIRS AT 750MM CENTRES WHERE APPROPRIATE AND ADEQUATELY IN


FORMWORK


4.1. ALL FORMWORK SHALL BE DESIGNED AND CONSTRUCTED IN ACCORDANCE WITH AS1509


AM


LV

4.2. RETAIN ALL FORMWORK IN POSITION FOR AT LEAST SEVEN DAYS

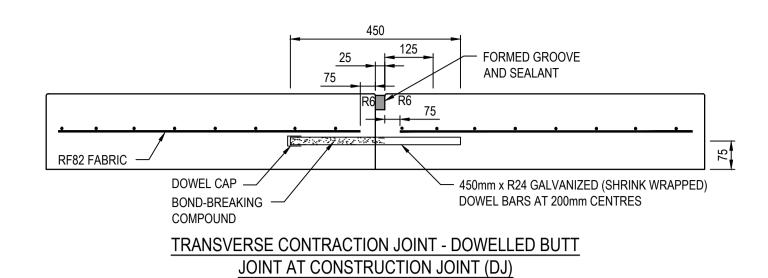

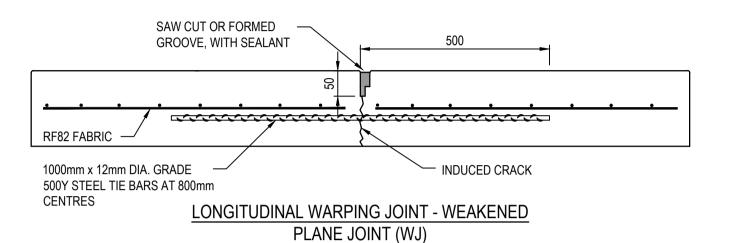


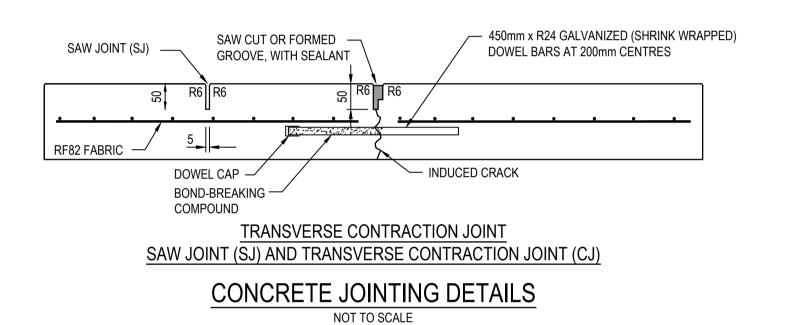

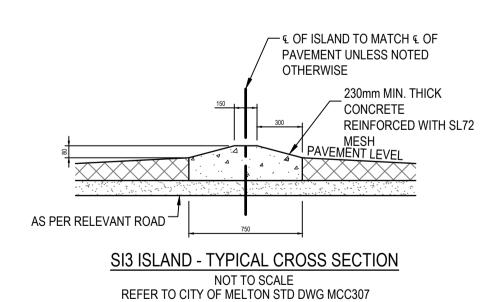





APPROVAL All setting out should be carried out in accordance with MPA/Council's standard drawings or as nominated on hard copy plans provided by SMEC. Any digital information supplied by this office is for information only. Any discrepancies should be discussed with the superintendent.

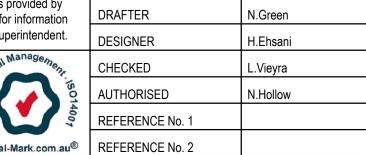

NAME

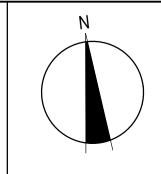

SCALE AS SHOWN AT A1

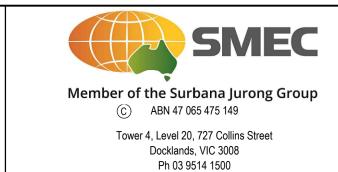



Seventh Bend - Stage 13

Melton City Council

Road and Drainage General Notes and Details

21 of 22 B


MELWAYS REF PROJECT / DRAWING No. 2250E-13-21

<u>PHASE</u>	DISCI	PLINE CODE		uction- Operations- Maintenance ENTIAL RISK	RISK OWNER	POTENTIAL CONSEQUENCES	POTENTIAL ELIMINATION MEASURE, DESIGN INITIATIVE or CONTROL (Identify any Standard or Code of practice used)	HOW ISSUE ADDRESED IN DESIGN AND/OR CONSTRUCTION OF THE WORKS	IS THE RISK ELIMINATED YES/NO	Residual Risk Likelihood (0-5)	Residual Risk Consequ ence (0-5)	Residual Risk Rating	RESIDUAL RISK OWNER
Construction	RD	Roads	Construction close to live traffic	New works will be constructed adjacent to live traffic when abutting existing stages.	Contractor	Disruptions to live traffic, construction incident involving live traffic.	Provide safe temporary traffic control (TCP)	TCP provided within contract	N	5	3	15	Constructor
Construction	US	Utilities or Services	Utilities become a hazard within clear zones	Vehicle conflict with utility / pit	Contractor	Personal injury, vehicle damage	Sequence works and protect with temp barrier or traffic control (TCP)	TCP provided within contract	N	1	5	5	Constructor
Operational	RD	Roads	Sight Lines	Inadequate drivers response time.	Road Authority	Increased potential for accidents	Ensure design complies with relevant standard. Undertake thorough Safety Audit	Vis lines checked and discussed with approval authority as part of design approval process	N	1	4	4	Road Authority
Operational	LS	Lines and Signs	Signs and street lights	Potential for drivers / riders to strike signs and street lights	Road Authority	Increased potential for accidents	Ensure design complies with relevant standard. Undertake thorough Safety Audit	Refer to appropriate standard for sign and lighting offsets	N	1	4	4	Road Authority
			Drainage										
Operational	DR	Drainage	Grated Pits	Trip/fall hazard with large spaced grate	Relevant Authority	Increased potential for accidents	Provide pedestrian/bicycle friendly grates where applicable. Refer to pit schedule	Design in accordance with authority and manufacturers standards	N	3	2	6	Authority
Operational	DR	Drainage	Non Standard Large Pits	Potential for pit failure	Relevant Authority	Increased risk to maintenance crews/ vehicles	Structural design in accordance with relevant design principles.	Refer to structural drawings and calculations	N	1	4	4	Authority
Maintenance	DR	Drainage	Access to Pits	Lack of safe access for maintenance	Relevant Authority	Increased risk to maintenance crews	Provide safe working conditions for maintenance. Provide safe landing/ access arrangements as per relevant authority standards	Where possible design pit in location for easy access and outside of permanent water bodies	N	2	5	10	Authority
Maintenance	DR	Drainage	Deep Pits	Lack of safe entry for maintenance	Relevant Authority	Increased potential for accidents	Contractor to be certified for work in confined spaces, step irons to be provided to appropriate authority standards. Refer to pit schedule	Design in accordance with authority standards	N	1	5	5	Authority
Maintenance	DR	Drainage	Access to drains / culverts	Lack of safe access for maintenance	Relevant Authority	Increased risk to maintenance crews	Provide safe working conditions for maintenance. Access as approved by authority	Design pit in location for easy access as agreed with authority	N	2	3	6	
		•	Sewer										
Maintenance	SE	Sewer	Deep Manholes	Lack of safe entry for maintenance	Relevant Authority	Increased potential for accidents	Contractor to be certified for work in confined spaces, landings and step access provided as per authority standards and schedule	Design in accordance with authority standards. Refer pit schedule on drawings	N	1	5	5	Authority
Maintenance	SE	Sewer	Access to Manholes	Lack of safe access for maintenance	Relevant Authority	Increased risk to maintenance crews	Provide safe working conditions for maintenance. Manholes located in compliance with authority standards	Where possible design manhole in location for easy access	N	1	5	5	Authority
			Electricity										
Operational	ES	Electrical Services	Electrical Design	Location of assets within clear zones e.g., pits/ substations	Relevant Authority	Increased potential for accidents	Electrical designed by sub consultant with appropriate accreditation and in accordance with authority standards	Pits designed below ground. Where above ground adequate offset from vehicle clear zones has been provided or barrier protection provided	N	2	3	6	Authority
			Telstra										
Operational	TE	Telstra	Telstra Design	Location of assets within clear zones e.g., pits	Relevant Authority	Increased potential for accidents	Telecommunications designed by authority consultant with appropriate accreditation and in accordance with authority standards	Pits designed below ground. Where above ground adequate offset from vehicle clear zones has been provided or barrier protection provided	N	2	3	6	Authority
			Water										
Operational	WA	Water	Water Design	Location of assets within clear zones e.g., pits/ substations	Relevant Authority	Increased potential for accidents	Water pits designed in accordance with authority standards	Pits designed below ground. Where above ground adequate offset from vehicle clear zones has been provided or barrier protection provided	N	2	3	6	Authority
	Gas		Gas										
Operational	GA	Gas	Gas Design	Location of assets within clear zones e.g., pits/ substations	Relevant Authority	Increased potential for accidents	Water pits designed in accordance with authority standards	Pits designed below ground. Where above ground adequate offset from vehicle clear zones has been provided or barrier protection provided	N	1	1	1	Authority

Г		SUBJECT TO APPROVA	L		Tilleno (Tilleno)
A	03.04.20	ISSUED TO COUNCIL FOR APPROVAL	HE/NG	NH	standard drav SMEC. Any dig only. Any discr
REV	DATE	AMENDMENT / REVISION DESCRIPTION	DES/DFT	APPROVAL	All setting out s

DES/DFT APPROVAL All setting out should be carried out in accordance with MPA/Council's rawings or as nominated on hard copy plans provided by digital information supplied by this office is for information screpancies should be discussed with the superintendent.

Global-Mark.com.au® Global-Mark.com.au® Global-Mark.com.au® REFERENCE No. 2

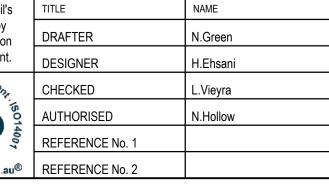

SCALE AS SHOWN AT A1



Tower 4, Level 20, 727 Collins Street Docklands, VIC 3008 Ph 03 9514 1500

SEVENTH BEND

Seventh Bend - Stage 13

Melton City Council

Road and Drainage

Safety In Design

MELWAYS REF PROJECT / DRAWING No. 2250E-13-85 SHEET No. REVISION A